

SHT	DRAWING SHEET TITLE	DATE	CURRENT REVISION DESCRIPTION
1	ELECTRICAL DRAWING LIST	May 23, 2024	Jan 13, 2026
2	GENERAL NOTES	May 23, 2024	
3	ELECTRICAL SYSTEM OUTLINE	May 23, 2024	
4	EQUIPMENT LAYOUT	May 23, 2024	
5	COMPACTLOGIX LAYOUT	May 23, 2024	
6	SET-UP PARAMETERS	May 23, 2024	
7	INCOMING 3 PHASE & POWER DISTRIBUTION - 115VAC & 24VDC CONTROL POWER	May 23, 2024	
8	POWER DISTRIBUTION - INCLINE CONVEYOR 1 & UPGRADE ACCUMULATOR	May 23, 2024	
9	POWER DISTRIBUTION - DISTRIBUTION CONVEYOR 1, 2 & 3	May 23, 2024	
10	POWER DISTRIBUTION - DISTRIBUTION CONVEYOR 4, 5 & 6	May 23, 2024	
11	POWER DISTRIBUTION - WEIGHER FEEDER 1, 2 & 3	May 23, 2024	
12	POWER DISTRIBUTION - WEIGHER FEEDER 4, 5 & 6	May 23, 2024	
13	CONTROL SCHEMATIC - SAFETY RELAY & CONTROL POWER	May 23, 2024	
14	CONTROL SCHEMATIC - 24VDC DIGITAL INPUT, RACK 0, SLOT 1	May 23, 2024	
15	CONTROL SCHEMATIC - 24VDC DIGITAL INPUT, RACK 0, SLOT 2	May 23, 2024	
16	CONTROL SCHEMATIC - 24VDC DIGITAL INPUT, RACK 0, SLOT 3	May 23, 2024	
17	CONTROL SCHEMATIC - 24VDC DIGITAL INPUT, RACK 0, SLOT 4	May 23, 2024	
18	CONTROL SCHEMATIC - WEIGHER RELAY BOARD 1, 2 & 3	May 23, 2024	
19	CONTROL SCHEMATIC - WEIGHER RELAY BOARD 4, 5 & 6	May 23, 2024	
20	PANEL LAYOUT	May 23, 2024	
21	BACKPANEL LAYOUT	May 23, 2024	
22	BILL OF MATERIALS	May 23, 2024	Jan 13, 2026

PLC 1769-L33ER software version 33.011

ALL RIGHTS OF DESIGN
OR INVENTION ARE RESERVED.

ELECTRICAL DRAWING LIST
-
MAIN CONTROL PANEL - CPI
WEIGHER INFEED CONTROL STATION

DESIGNED BY
PABLO REYES
DRAWING BY
ALDO REYES
CHECKED BY
SCALE
DATE
May 23, 2024

NOTES:

SHEET
1

AYOUT

NOTES: UNLESS OTHERWISE SPECIFIED

- ① NOMINAL SYSTEM VOLTAGES SHOULD BE WITHIN THE FOLLOWING TOLERANCES PER ANSI C84.1-1982[2] AND ANSI/NEMA MG1-1987[8]: NOMINAL VOLTAGE: +5.8% -8.3%.
- ② ELECTRICAL INSTALLATION TO BE PERFORMED IN ACCORDANCE WITH THE CURRENT REVISION OF THE NATIONAL ELECTRICAL CODE (NEC), STATE AND LOCAL REQUIREMENTS.
- ③ ENCLOSURE GROUND WIRING IS TO BE GREEN AND ATTACHED TO THE COMMON GROUND LUG.
- ④ LOCKOUT / TAGOUT PROCEDURES MUST BE FOLLOWED AT ALL TIMES PRIOR TO OPENING OR SERVICING THE ENCLOSURE AND/OR EQUIPMENT.
- 5) FIELD INTERCONNECTING WIRING TO BE FURNISHED BY CUSTOMER.
- 6) THIS INDUSTRIAL CONTROL PANEL SHALL BE BUILT TO NFPA 79 & NFPA 86 (2015) STANDARDS.
- 7) THIS INDUSTRIAL CONTROL PANEL SHALL BE UL LABELED TO UL508A STANDARDS.
- 8) DO NOT RUN AC & DC WIRING IN THE SAME CONDUIT.
- 9) LOW LEVEL SHIELDED DC SIGNAL WIRING SHOULD BE GROUNDED AT ONE END.
- 10) CONDUIT IS TO BE RUN INTO THE BOTTOM OR SIDES OF ENCLOSURES, NOT INTO THE TOP.
- 11) REFERENCE THE VFD MANUFACTURER'S USER MANUAL FOR RECOMMENDED INSTALLATION CRITERIA.
- 12) USE UL LISTED CLOSED-LOOP CRIMP TERMINALS WHEN WIRING TO YASKAWA V1000 MAIN CIRCUIT TERMINALS. SEE MANUFACTURER'S USER MANUAL FOR PROPER TERMINAL SIZING.
- 13) FIELD INSTALLATION RECOMMENDATIONS:
 - 3-PHASE POWER WIRING: MINIMUM #12AWG, 600V INSULATION, 90°C, THHN OR EQUIVALENT
 - 1-PHASE CONTROL WIRING: MINIMUM #14AWG, 600V INSULATION, 90°C, THHN OR EQUIVALENT
 - DC CONTROL WIRING: MINIMUM #14AWG, 600V INSULATION, 90°C, THHN OR EQUIVALENT
 - 2-CONDUCTOR DC SIGNAL WIRING: MINIMUM #18AWG, STRANDED W/ SHIELD, 300V INSULATION, (I.E. BELDEN 8760 OR EQUIVALENT)
 - 3-CONDUCTOR DC SIGNAL WIRING: MINIMUM #18AWG, STRANDED W/ SHIELD, 300V INSULATION, (I.E. BELDEN 8770 OR EQUIVALENT)

LEGEND

- FACTORY WIRING
- FIELD WIRING BY CUSTOMER
- FACTORY WIRING BY HEAT AND CONTROL
- ② TERMINALS LOCATED IN MAIN CONTROL PANEL - CP1 (451960-01)
- ① TERMINALS LOCATED IN ACCUMULATOR JUNCTION BOX (BY GALESBURG)
- ② TERMINALS LOCATED IN DISTRIBUTION CONVEYOR 1 JUNCTION BOX (BY GALESBURG)
- ③ TERMINALS LOCATED IN DISTRIBUTION CONVEYOR 2 JUNCTION BOX (BY GALESBURG)
- ④ TERMINALS LOCATED IN DISTRIBUTION CONVEYOR 3 JUNCTION BOX (BY GALESBURG)
- ⑤ TERMINALS LOCATED IN WEIGHER FEEDER 1 JUNCTION BOX (BY GALESBURG)
- ⑥ TERMINALS LOCATED IN WEIGHER FEEDER 2 JUNCTION BOX (BY GALESBURG)
- ⑦ TERMINALS LOCATED IN WEIGHER FEEDER 3 JUNCTION BOX (BY GALESBURG)
- ① TERMINALS LOCATED IN WEIGHER 1 JUNCTION BOX (BY OTHERS)
- ② TERMINALS LOCATED IN WEIGHER 2 JUNCTION BOX (BY OTHERS)
- ③ TERMINALS LOCATED IN WEIGHER 3 JUNCTION BOX (BY OTHERS)
- X DESIGNATES NOTE SPECIFIC TO ITEM ON A GIVEN SHEET (LOCAL NOTE FLAG).
- XX DESIGNATES NOTE TO REFERENCE ON GENERAL NOTES SHEET (GLOBAL NOTE FLAG).

REFERENCE NOTATIONS:

XX-XX
SHEET #
LINE #

DESIGNATES CONTROL PANEL.
DESIGNATES TERMINAL/WIRE NUMBER.

DESIGNATES WIRE NUMBER.

CONFIDENTIAL

ALL RIGHTS OF DESIGN
OR INVENTION ARE RESERVED.

GENERAL NOTES
-
MAIN CONTROL PANEL - CP1
WEIGHER INFEED CONTROL STATION


DESIGNED BY
PABLO REYES
DRAWING BY
ALDO REYES
CHECKED BY
SCALE
NONE
DATE
May 23, 2024

NOTES:

SHEET

2


CONFIDENTIAL

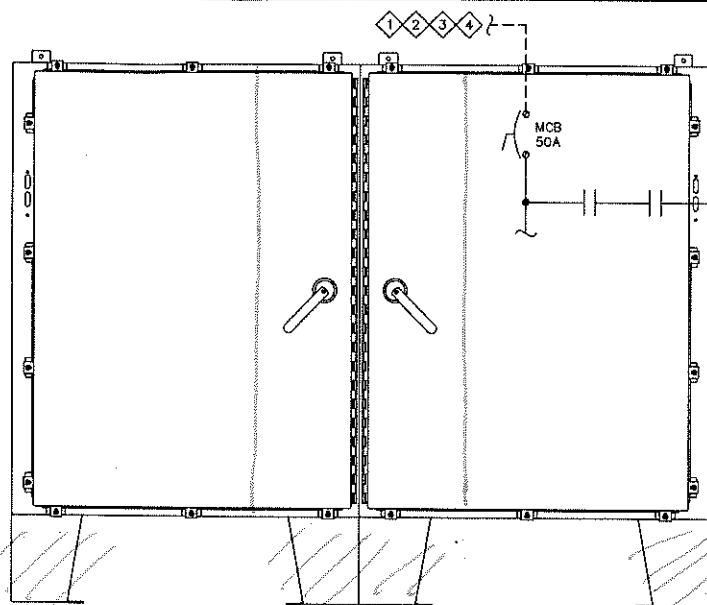

(451960-01)
84"H x 120"W x 18"D
ON "12" LEGS
NEMA 12
STAINLESS STEEL
NATURAL COLOR
3 door panel
floor mounted

NOTES: UNLESS OTHERWISE SPECIFIED

- 1 NOMINAL SYSTEM VOLTAGES SHOULD BE WITHIN THE FOLLOWING TOLERANCES PER ANSI C84.1-1982[2] AND ANSI/NEMA MG1-1987[8]: NOMINAL VOLTAGE: +5.8% -5.3%
- 2 ELECTRICAL INSTALLATION TO BE PERFORMED IN ACCORDANCE WITH THE CURRENT REVISION OF THE NATIONAL ELECTRICAL CODE (NEC), STATE AND LOCAL REQUIREMENTS.
- 3 ENCLOSURE GROUND WIRING IS TO BE GREEN AND ATTACHED TO THE COMMON GROUND LUG.
- 4 LOCKOUT / TAGOUT PROCEDURES MUST BE FOLLOWED AT ALL TIMES PRIOR TO OPENING OR SERVICING THE ENCLOSURE AND/OR EQUIPMENT.
- 5 FIELD INTERCONNECTING WIRING TO BE FURNISHED BY CUSTOMER.

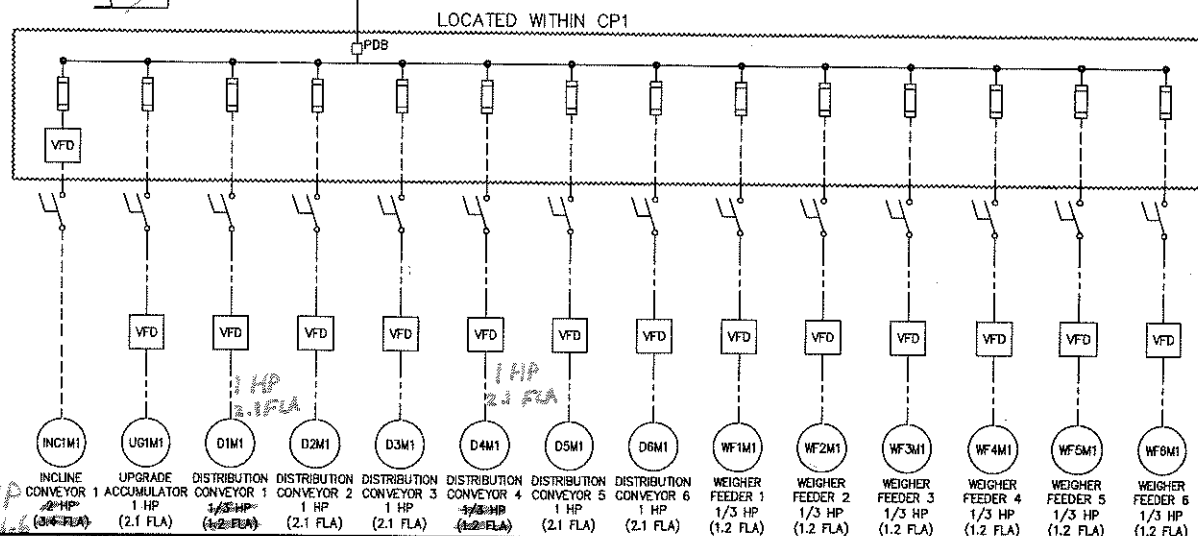

ALL RIGHTS OF DESIGN OR INVENTION ARE RESERVED.

ELECTRICAL SYSTEM OUTLINE
MAIN CONTROL PANEL - CP1
WEIGHER INFEED CONTROL STATION


DESIGNED BY
PABLO REYES
DRAWING BY
ALDO REYES
CHECKED BY
SCALE
NONE
DATE
May 23, 2024

NOTES:

SHEET

3

CONFIDENTIAL

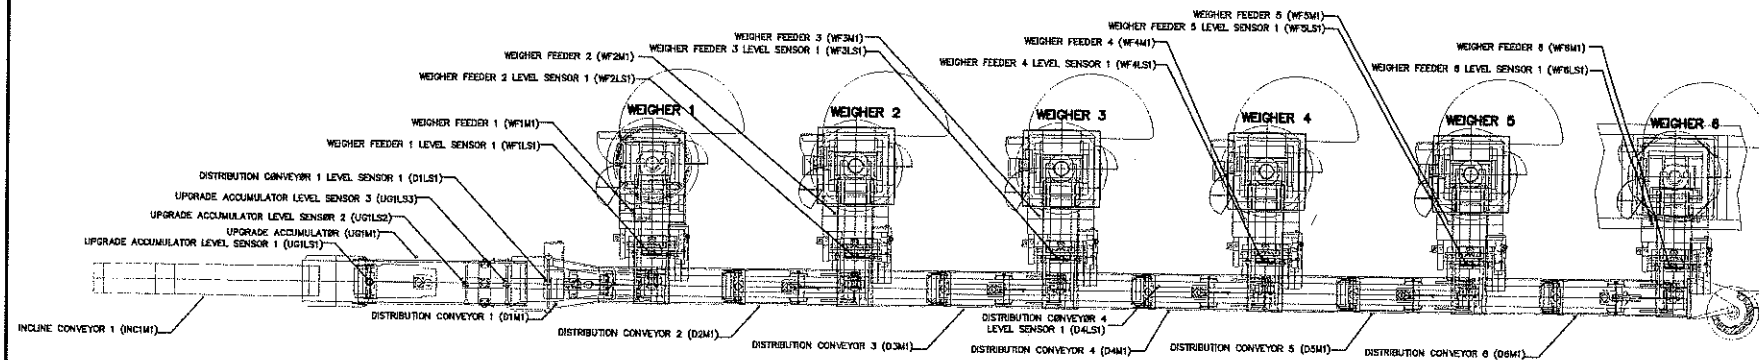

ALL RIGHTS OF DESIGN
OR INVENTION ARE RESERVED.


EQUIPMENT LAYOUT
-
MAIN CONTROL PANEL - CP1
WEIGHER INFEED CONTROL STATION

DESIGNED BY
PABLO REYES
DRAWING BY
ALDO REYES
CHECKED BY
SCALE
NONE
DATE
May 23, 2024


NOTES:

SHEET
4

IP 192.168.1.100
(port 2)
subnet 255.255.255.0

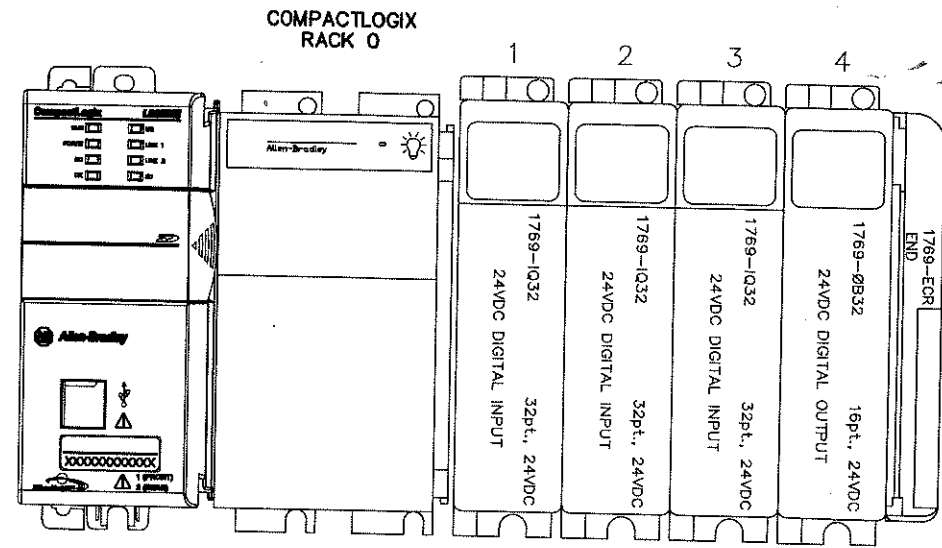

CompactLogix L33ERM

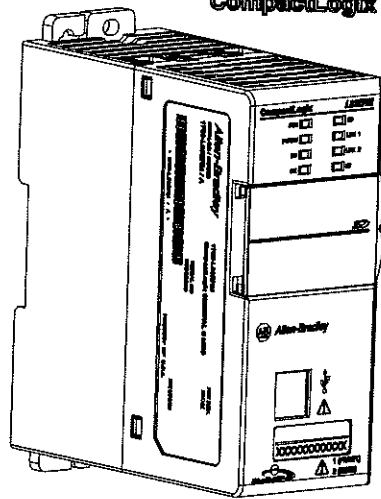

CONFIDENTIAL

ALL RIGHTS OF DESIGN OR INVENTION ARE RESERVED.	COMPACTLOGIX LAYOUT 24VDC DIGITAL OUTPUT, RACK 0, SLOT 4 MAIN CONTROL PANEL - CP1 WEIGHER INFED CONTROL STATION	DESIGNED BY FABLO REYES DRAWING BY ALDO REYES CHECKED BY SCALE NONE DATE May 23, 2024	NOTES:	SHEET 5
---	--	--	--------	--------------------

PARAMETER	NAME	SETTING RANGE	FACTORY SETTING	INCLINE CONVEYOR 1 INC1M1 IN CP1	UPGRADE ACCUMULATOR UG1M1 IN FASTBACK	DISTRIBUTION CONVEYOR 1 D1M1 IN FASTBACK	DISTRIBUTION CONVEYOR 2 D2M1 IN FASTBACK	DISTRIBUTION CONVEYOR 3 D3M1 IN FASTBACK	WEIGHER FEEDER 1 WF1M1 IN FASTBACK	WEIGHER FEEDER 2 WF2M1 IN FASTBACK	WEIGHER FEEDER 3 WF3M1 IN FASTBACK
E1-01	Frequency Reference Selection 1	0 to 1	1	0 (SINGLE SPEED)	0 (SINGLE SPEED)	0 (SINGLE SPEED)	0 (SINGLE SPEED)	0 (SINGLE SPEED)	0 (SINGLE SPEED)	0 (SINGLE SPEED)	0 (SINGLE SPEED)
E1-02	Run Method Selection	0 to 1	1	0 (SINGLE SPEED)	0 (SINGLE SPEED)	0 (SINGLE SPEED)	0 (SINGLE SPEED)	0 (SINGLE SPEED)	0 (SINGLE SPEED)	0 (SINGLE SPEED)	0 (SINGLE SPEED)
E1-03	Stopping Method Selection	0 to 1	1	0 (SINGLE SPEED)	0 (SINGLE SPEED)	0 (SINGLE SPEED)	0 (SINGLE SPEED)	0 (SINGLE SPEED)	0 (SINGLE SPEED)	0 (SINGLE SPEED)	0 (SINGLE SPEED)
D1-04	Reverse Operation Selection	0 to 1	0	0 (SINGLE SPEED)	0 (SINGLE SPEED)	0 (SINGLE SPEED)	0 (SINGLE SPEED)	0 (SINGLE SPEED)	0 (SINGLE SPEED)	0 (SINGLE SPEED)	0 (SINGLE SPEED)
E1-17	Run Command at Power Up	0 to 1	0	0 (SINGLE SPEED)	0 (SINGLE SPEED)	0 (SINGLE SPEED)	0 (SINGLE SPEED)	0 (SINGLE SPEED)	0 (SINGLE SPEED)	0 (SINGLE SPEED)	0 (SINGLE SPEED)
D2-02	DC Injection Braking Current	0 to 1	0	1 (RUN AT POWER UP)	1 (REVERSE DISABLED)	1 (REVERSE DISABLED)	1 (REVERSE DISABLED)	1 (REVERSE DISABLED)	1 (REVERSE DISABLED)	1 (REVERSE DISABLED)	1 (REVERSE DISABLED)
E2-03	DC Injection Braking Time at Start	0 to 75	50%	1 (RUN AT POWER UP)	1 (RUN AT POWER UP)	1 (RUN AT POWER UP)	1 (RUN AT POWER UP)	1 (RUN AT POWER UP)	1 (RUN AT POWER UP)	1 (RUN AT POWER UP)	1 (RUN AT POWER UP)
D2-04	DC Injection Braking Time at Stop	0.00 to 10.00	0.50 sec	0	0	0	0	0	0	0	0
E0-01	Energy Saving Control Selection	0 to 1	0	0	0	0	0	0	0	0	0
E1-01	Acceleration Time 1	0.00 to 10.00	0.50 sec	0	0	0	0	0	0	0	0
C1-02	Deceleration Time 1	0.0 to 5000.0	10.0 sec	1.0 sec	0.6 sec	0.6 sec	0.6 sec	0.6 sec	0.6 sec	0.6 sec	0.6 sec
C1-03	Acceleration Time 2	0.0 to 5000.0	10.0 sec	1.0 sec	0.6 sec	0.6 sec	0.6 sec	0.6 sec	0.6 sec	0.6 sec	0.6 sec
C1-04	Deceleration Time 2	0.0 to 5000.0	10.0 sec	1.0 sec	0.6 sec	0.6 sec	0.6 sec	0.6 sec	0.6 sec	0.6 sec	0.6 sec
C2-03	S Curve Characteristic at Decel Start	0.00 to 10.00 sec	0.20 sec	0	0	0	0	0	0	0	0
C2-01	Torque Compensation Gain	0.00 to 2.50	1.00	0	0	0	0	0	0	0	0
E0-01	Normal/Heavy Duty Selection	0 to 1	1	0	0	0	0	0	0	0	0
C0-02	Carrier Frequency Selection	0 to 1	1	0 (HEAVY DUTY)	0 (HEAVY DUTY)	0 (HEAVY DUTY)	0 (HEAVY DUTY)	0 (HEAVY DUTY)	0 (HEAVY DUTY)	0 (HEAVY DUTY)	0 (HEAVY DUTY)
D1-01	Frequency Reference 1	0.00 to 400.00 Hz	0.00 Hz	60.00 Hz	50.00 Hz	50.00 Hz	50.00 Hz	50.00 Hz	50.00 Hz	50.00 Hz	50.00 Hz
D1-02	Frequency Reference 2	0.00 to 400.00 Hz	0.00 Hz	60.00 Hz	50.00 Hz	50.00 Hz	50.00 Hz	50.00 Hz	50.00 Hz	50.00 Hz	50.00 Hz
D1-03	Frequency Reference 3	0.00 to 400.00 Hz	0.00 Hz	60.00 Hz	50.00 Hz	50.00 Hz	50.00 Hz	50.00 Hz	50.00 Hz	50.00 Hz	50.00 Hz
D1-04	Frequency Reference 4	0.00 to 400.00 Hz	0.00 Hz	60.00 Hz	50.00 Hz	50.00 Hz	50.00 Hz	50.00 Hz	50.00 Hz	50.00 Hz	50.00 Hz
D3-01**	Jump Frequency 1	0.00 to 400.00 Hz	0.00 Hz	60.00 Hz	50.00 Hz	50.00 Hz	50.00 Hz	50.00 Hz	50.00 Hz	50.00 Hz	50.00 Hz
D3-04**	Jump Frequency Width	0.00 to 400.00 Hz	0.00 Hz	60.00 Hz	50.00 Hz	50.00 Hz	50.00 Hz	50.00 Hz	50.00 Hz	50.00 Hz	50.00 Hz
E1-03	V/F Pattern Selection	0 to 1	1	0	0	0	0	0	0	0	0
E1-04	Max Output Frequency	0 to 1	1	0	0	0	0	0	0	0	0
E1-05	Max Output Voltage	0.0 to 400.0 V	60 Hz <3>	60	50.0	50.0	50.0	50.0	50.0	50.0	50.0
E1-06	Base Frequency	0.0 to E1-04	60 Hz <3>	60	50.0	50.0	50.0	50.0	50.0	50.0	50.0
E1-07	Min Output Frequency	0.0 to E1-04	3 Hz <3>	3	50.0	50.0	50.0	50.0	50.0	50.0	50.0
E1-09	Minimum Output Frequency	0.0 to E1-04	3 Hz <3>	3	50.0	50.0	50.0	50.0	50.0	50.0	50.0
E2-01	Motor Rated Current	10 to 200% of DRC	1.5 Hz <3> <11>	3.4 (480 VAC)	2.0 (480 VAC)	1.15 (480 VAC)	2.0 (480 VAC)	2.0 (480 VAC)	1.15 (480 VAC)	1.15 (480 VAC)	1.15 (480 VAC)
E2-03	Motor No-Load Current	0 to less than E2-01	<4>	6	6	6	6	6	6	6	6
E2-04	Number of Motor Poles	2 to 48	4 poles	4	4	4	4	4	4	4	4
E2-11	Motor Rated Output	0.00 to 550.00	0.40 kW <4>	1.5	0.75	0.20	0.75	0.75	0.20	0.20	0.20
E0-01****	Communications Error Operation Selection	0 to 1	1	0	0	0	0	0	0	0	0
E0-02****	External Fault from Comm. Option Operation Selection	0 to 1	1	0	0	0	0	0	0	0	0
H1-07	Multi-Function Digital Input Terminal S7 Function Selection	0 to 1	1	0	0	0	0	0	0	0	0
H2-01	Terminal A1, A2 and A3 Function Selection <relay>	0 to 132 <7>	0 (4) <13>	0 - DURING RUN	0 - DURING RUN	0 - DURING RUN	0 - DURING RUN	0 - DURING RUN	0 - DURING RUN	0 - DURING RUN	0 - DURING RUN
H3-02**	Terminal A1 Function Selection	0 to 132 <7>	0	0 - DURING RUN	0 - DURING RUN	0 - DURING RUN	0 - DURING RUN	0 - DURING RUN	0 - DURING RUN	0 - DURING RUN	0 - DURING RUN
H3-04**	Terminal A2 Bias Selection	0 to 1	0	0	0	0	0	0	0	0	0
H3-05**	Terminal A2 Function Selection	0 to 1	0	0	0	0	0	0	0	0	0
H3-12**	Terminal A3 Input Bias	0 to 1	0	0	0	0	0	0	0	0	0
L1-01	Motor Overload Protection Selection	0 to 1	0	0	0	0	0	0	0	0	0
L2-01	Momentary Power Loss Operation Selection	0 to 1	1	0	0	0	0	0	0	0	0
L3-01	Stall Prevention Selection during Acceleration	0 to 2 <8>	0	1 (ENABLE/RECOVER)	1 (ENABLE/RECOVER)	1 (ENABLE/RECOVER)	1 (ENABLE/RECOVER)	1 (ENABLE/RECOVER)	1 (ENABLE/RECOVER)	1 (ENABLE/RECOVER)	1 (ENABLE/RECOVER)
L3-02	Stall Prevention Selection during Deceleration	0 to 2 <8>	0	0 (DISABLED)	0 (DISABLED)	0 (DISABLED)	0 (DISABLED)	0 (DISABLED)	0 (DISABLED)	0 (DISABLED)	0 (DISABLED)
L3-03	Stall Prevention Selection during Run	0 to 2 <8>	0	0 (DISABLED)	0 (DISABLED)	0 (DISABLED)	0 (DISABLED)	0 (DISABLED)	0 (DISABLED)	0 (DISABLED)	0 (DISABLED)
L3-04	Number of Auto Resets	0 to 10	0	0	0	0	0	0	0	0	0
L4-01	Torque Detection Selection 1	0 to 1	0	0	0	0	0	0	0	0	0
L4-02	Torque Detection Level 1	0 to 300	100%	0	0	0	0	0	0	0	0
L4-03	Torque Detection Time 1	0.0 to 10.0	0.1 s	0	0	0	0	0	0	0	0
L4-05	Input Phase Loss Protection Selection	0 to 1	0	0	0	0	0	0	0	0	0
L6-03	Installation Method Selection	0 to 1	0	0 (DISABLED)	0 (DISABLED)	0 (DISABLED)	0 (DISABLED)	0 (DISABLED)	0 (DISABLED)	0 (DISABLED)	0 (DISABLED)
A3-02	Copy Function READ Permission	0 to 1	0	1 (COPY ALLOWED)	1 (COPY ALLOWED)	1 (COPY ALLOWED)	1 (COPY ALLOWED)	1 (COPY ALLOWED)	1 (COPY ALLOWED)	1 (COPY ALLOWED)	1 (COPY ALLOWED)

* Optional for Multi-Speed Applications using Preset Speeds

** Optional for Variable Speed Applications Using a 4-20mA Reference Signal

*** Vary Speed as required for best operation; if operating higher than 60Hz, adjust variable E1-04.

**** For Use of Ethernet Communications Option

<1> Default setting value is dependent on parameters c2-04, Drive Model Selection, A1-02, Control Method Selection and C0-01, Normal/Heavy Duty selection.

<2> Values shown here are for 200 V class drives. Double the value when using a 400 V class drive.

<3> Default setting value is dependent on parameter E0-01, Motor Code Selection.

<4> Default setting value is dependent on parameter c2-04, Drive Model Selection and C0-01, Drive Duty Selection.

<5> Default setting value is dependent on parameter c2-04, Drive Model Selection.

<6> Default setting value is dependent on parameter E1-01, Input Voltage Setting.

<7> The availability of certain functions depends on the control method used.

<8> Setting value 2 is not available A1-02 = 5-PM OLV Control. When enabled, the drive stops accelerating when it exceeds the value of L3-02, Stall Prevention Level.

<9> Parameter setting value is not reset to the default value during drive initialization. A1-03 = 1110, 2220, 3330.

<10> Switch between current or voltage inputs by using DIP switch S1-2 switch on the terminal board.

<11> Default setting value is dependent on parameter A1-02, Control Method Selection. The value shown is for A1-02 = V/F Control.

<12> The availability of certain functions depends on the control method used.

<13> Parenthetical value is the default when parameter A1-03 = 3330 3-Wire Initialization.

see excel file dated 1-13-2026

CONFIDENTIAL

ALL RIGHTS OF DESIGN
OR INVENTION ARE RESERVED.

SET-UP PARAMETERS
-
MAIN CONTROL PANEL - CP1
WEIGHER INFEED CONTROL STATION


DESIGNED BY
PABLO REYES
DRAWING BY
ALDO REYES
CHECKED BY
SCALE
NONE
DATE
May 23, 2024

NOTES:


SHEET

6

AYOU

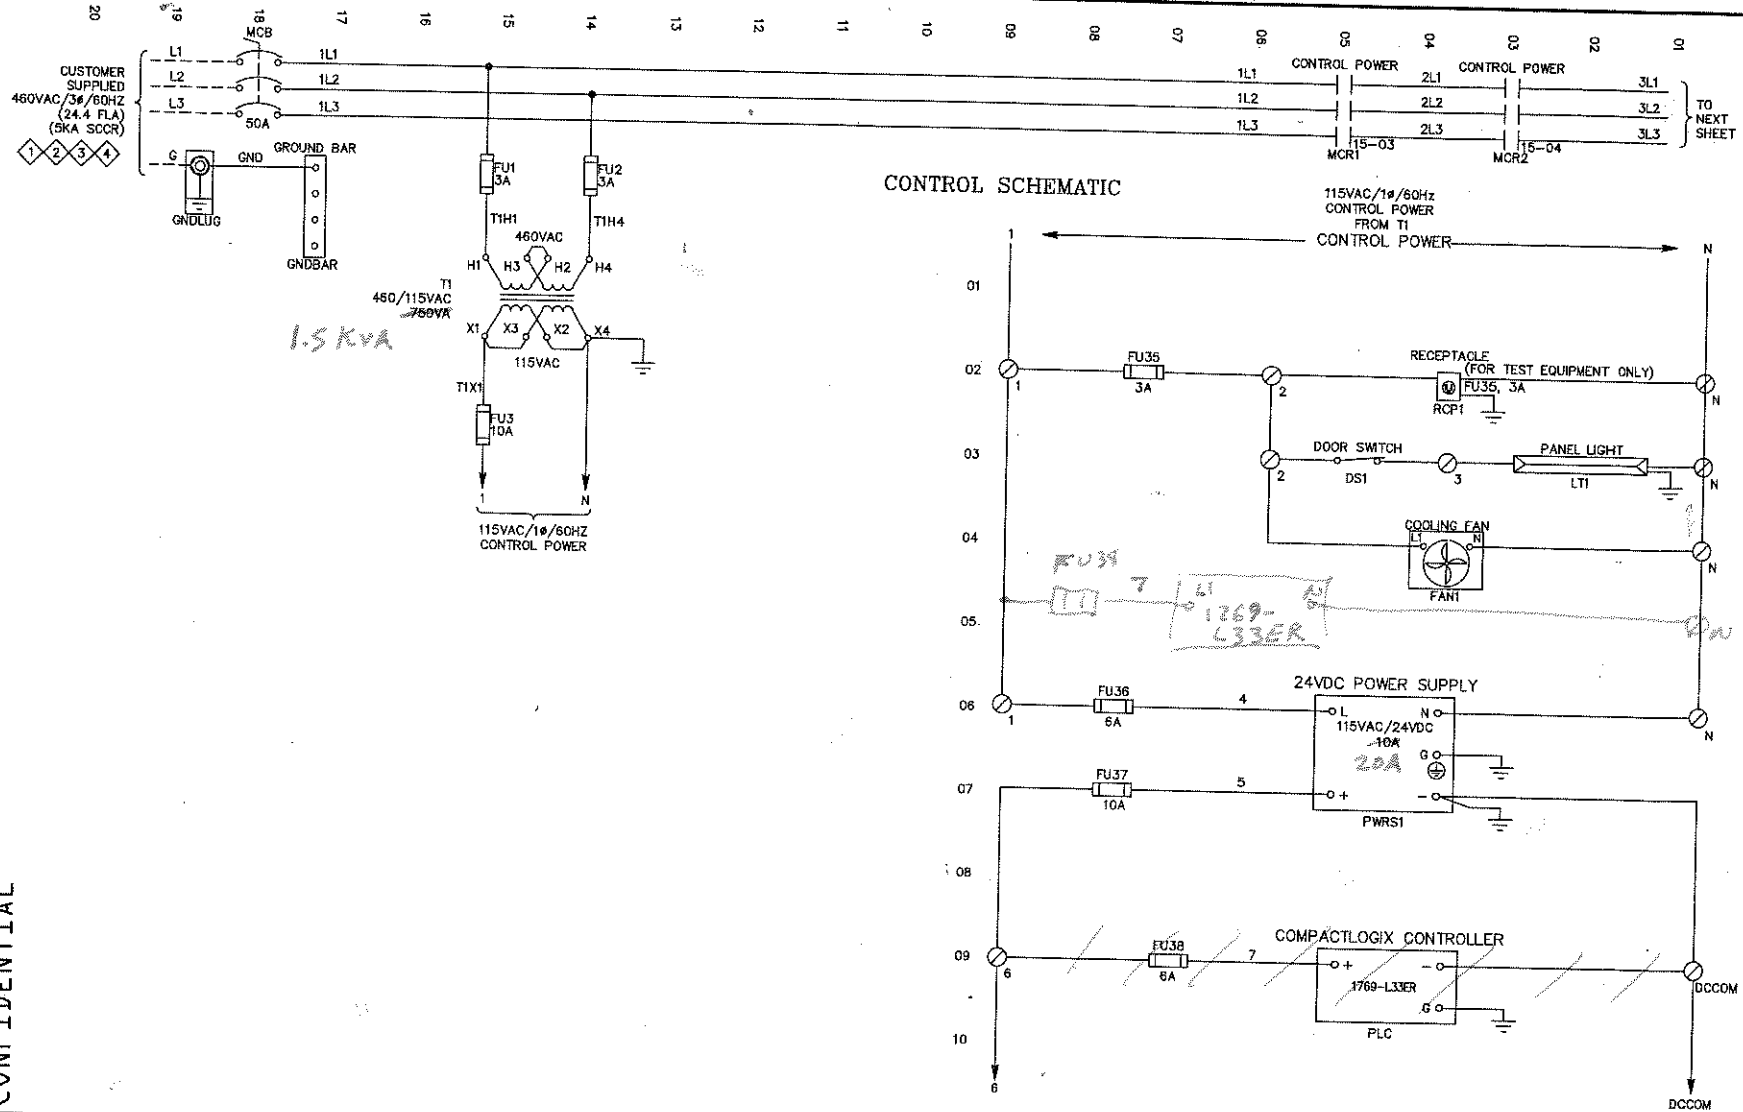

CONTROL SCHEMATIC

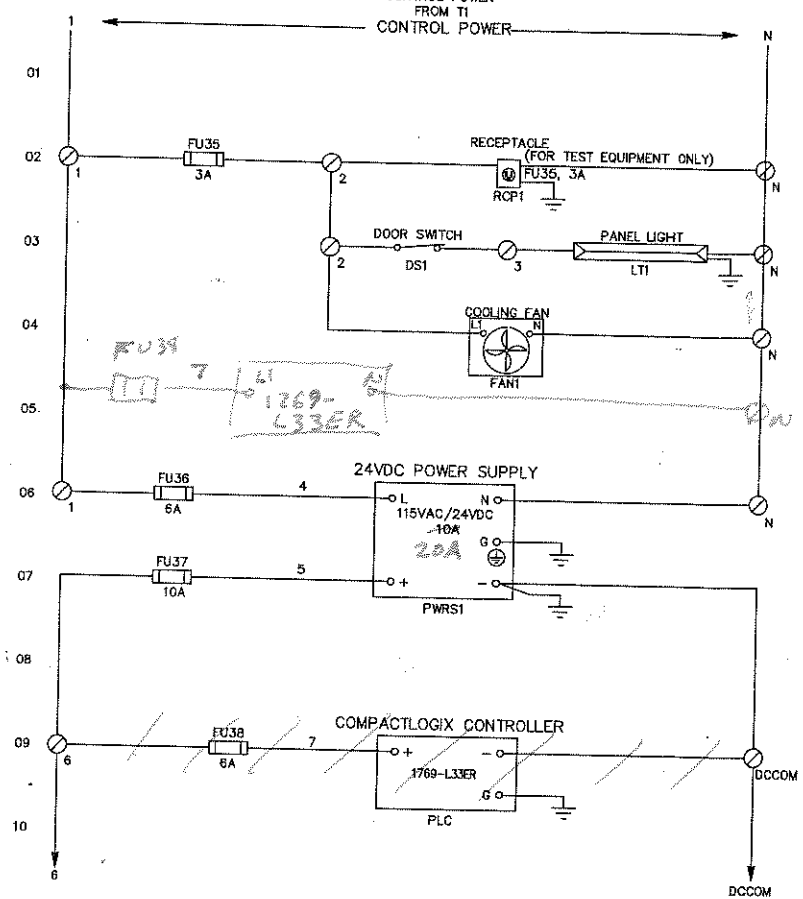

CONFIDENTIAL


ALL RIGHTS OF DESIGN
OR INVENTION ARE RESERVED.

INCOMING 3 PHASE & POWER DISTRIBUTION
INCOMING 115VAC & 24VDC CONTROL POWER
MAIN CONTROL PANEL - CP1
WEIGHER INFEED CONTROL STATION

DESIGNED BY
PARLO REYES
DRAWING BY
ALDO REYES
CHECKED BY
SCALE
NONE
DATE
May 23, 2024

NOTES:

SHEET
7

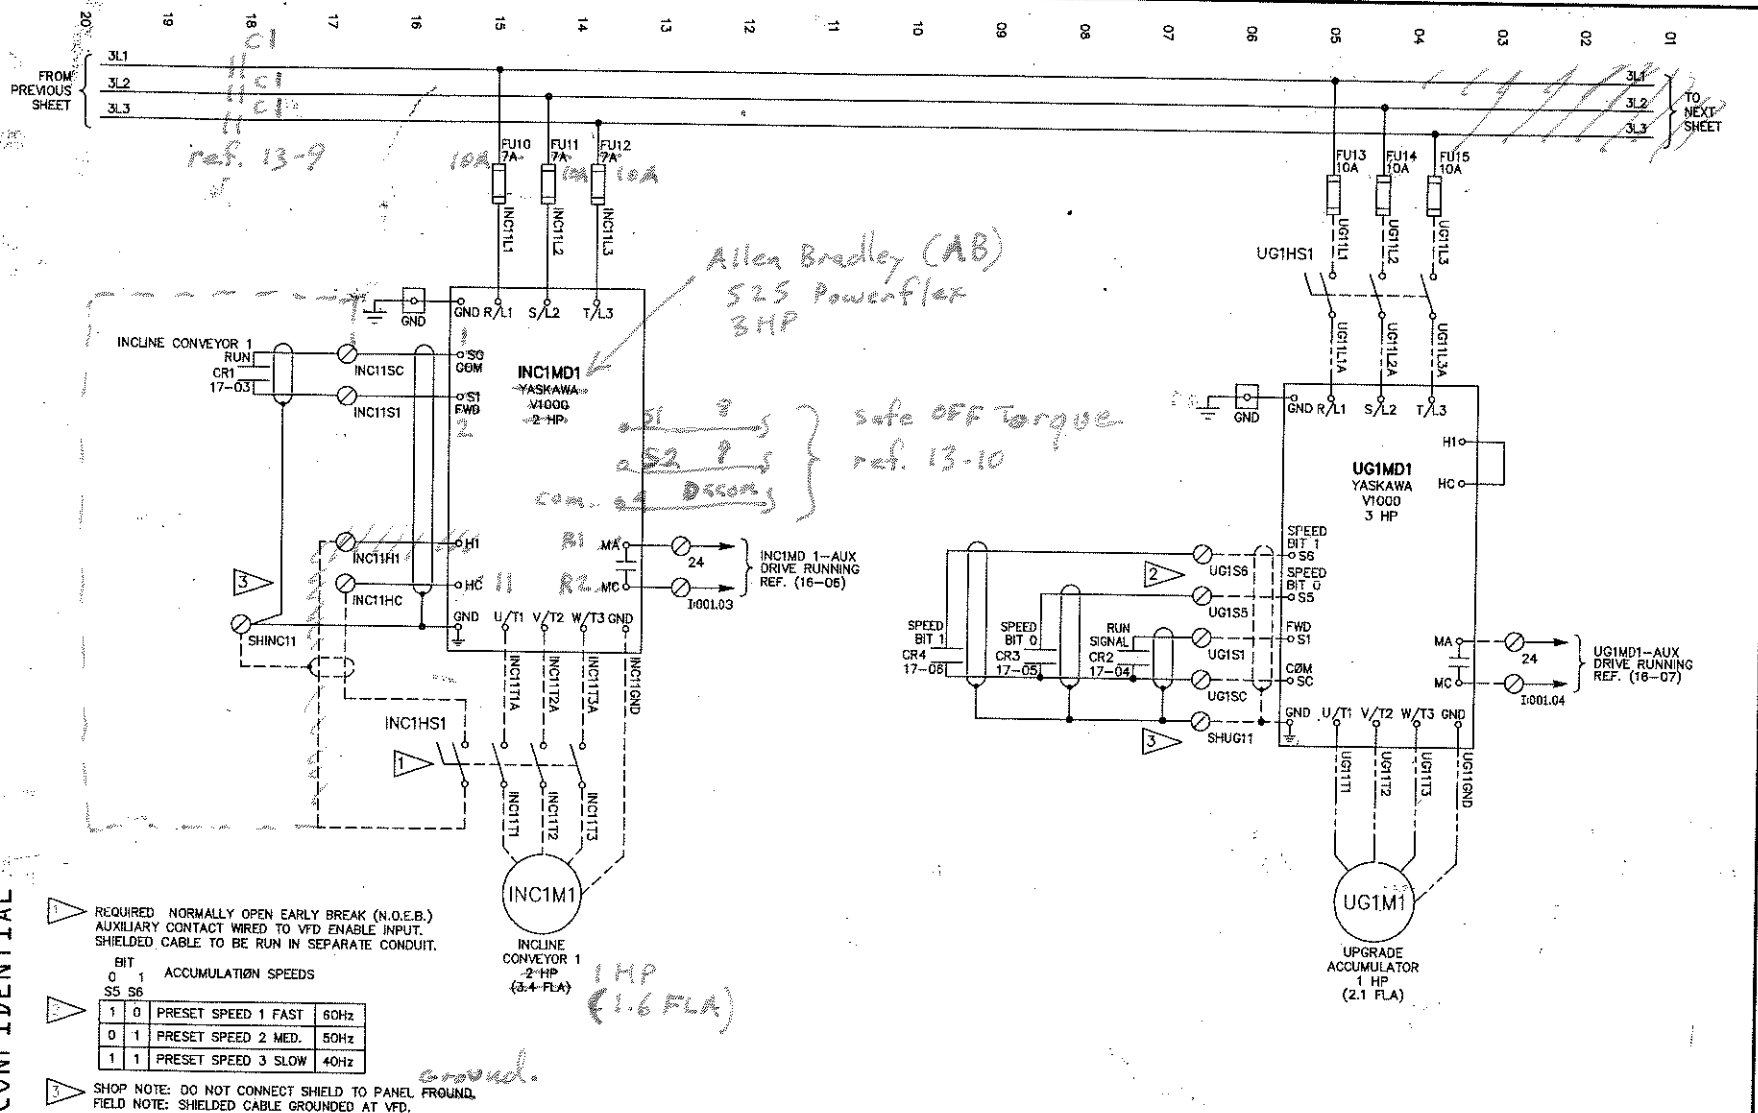

CONFIDENTIAL

ALL RIGHTS OF DESIGN
OR INVENTION ARE RESERVED.


POWER DISTRIBUTION
INCLINE CONVEYOR 1 & UPGRADE ACCUMULATOR
MAIN CONTROL PANEL - CPL
WEIGHER INFED CONTROL STATION

DESIGNED BY
PABLO REYES
DRAWING BY
ALDO REYES
CHECKED BY
SCALE
NONE
DATE
May 23, 2024

NOTES:

SHEET



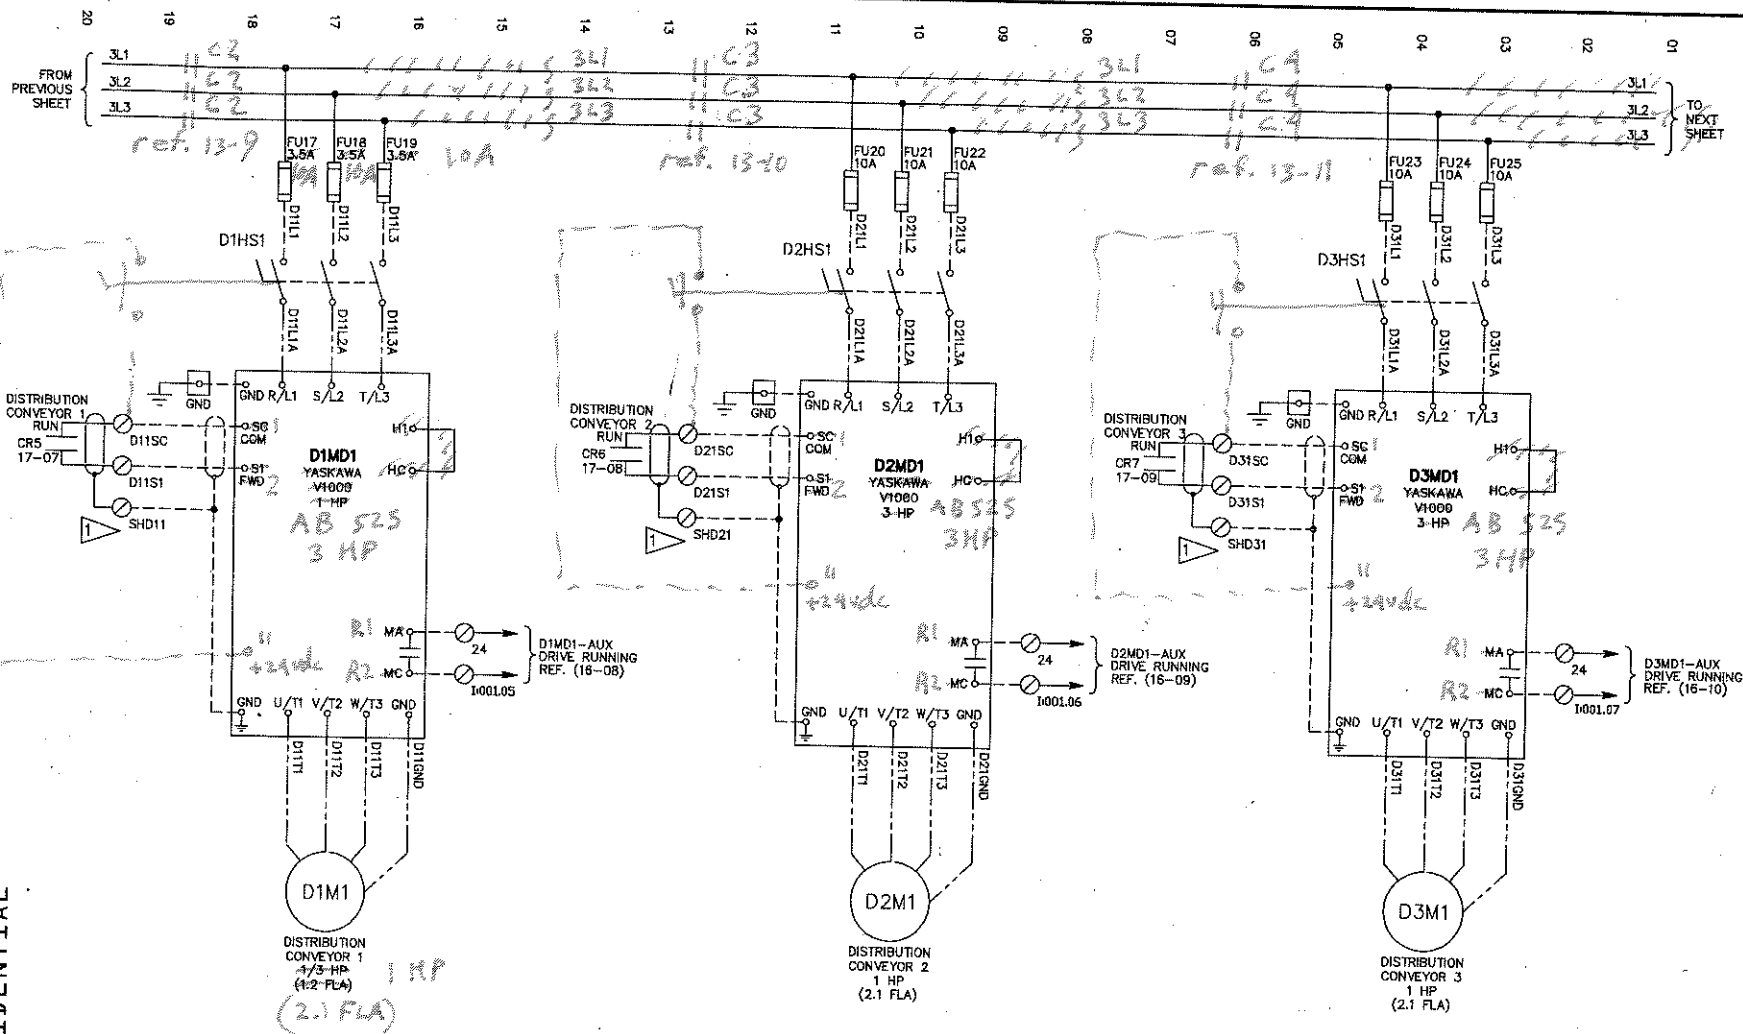

CONFIDENTIAL

SHOP NOTE: DO NOT CONNECT SHIELD TO PANEL GROUND.
FIELD NOTE: SHIELDED CABLE GROUNDED AT VFD.

ALL RIGHTS OF DESIGN
OR INVENTION ARE RESERVED.

POWER DISTRIBUTION
DISTRIBUTION CONVEYOR 1, 2 & 3
MAIN CONTROL PANEL - CPl
WEIGHER INFED CONTROL STATION

DESIGNED BY
PABLO REYES
DRAWING BY
ALDO REYES
CHECKED BY
SCALE
NONE
DATE
May 23, 2024

NOTES:

SHEET

9

CONFIDENTIAL

1 SHOP NOTE: DO NOT CONNECT SHIELD TO PANEL GROUND.
FIELD NOTE: SHIELDED CABLE GROUNDED AT VFD.

ALL RIGHTS OF DESIGN
OR INVENTION ARE RESERVED.


POWER DISTRIBUTION
DISTRIBUTION CONVEYOR 4, 5 & 6
MAIN CONTROL PANEL - CP1
WEIGHER INFEEED CONTROL STATION

DESIGNED BY
PABLO REYES
DRAWING BY
ALDO REYES
CHECKED BY
SCALE
NONE
DATE
May 23, 2024


NOTES:

SHEET

10

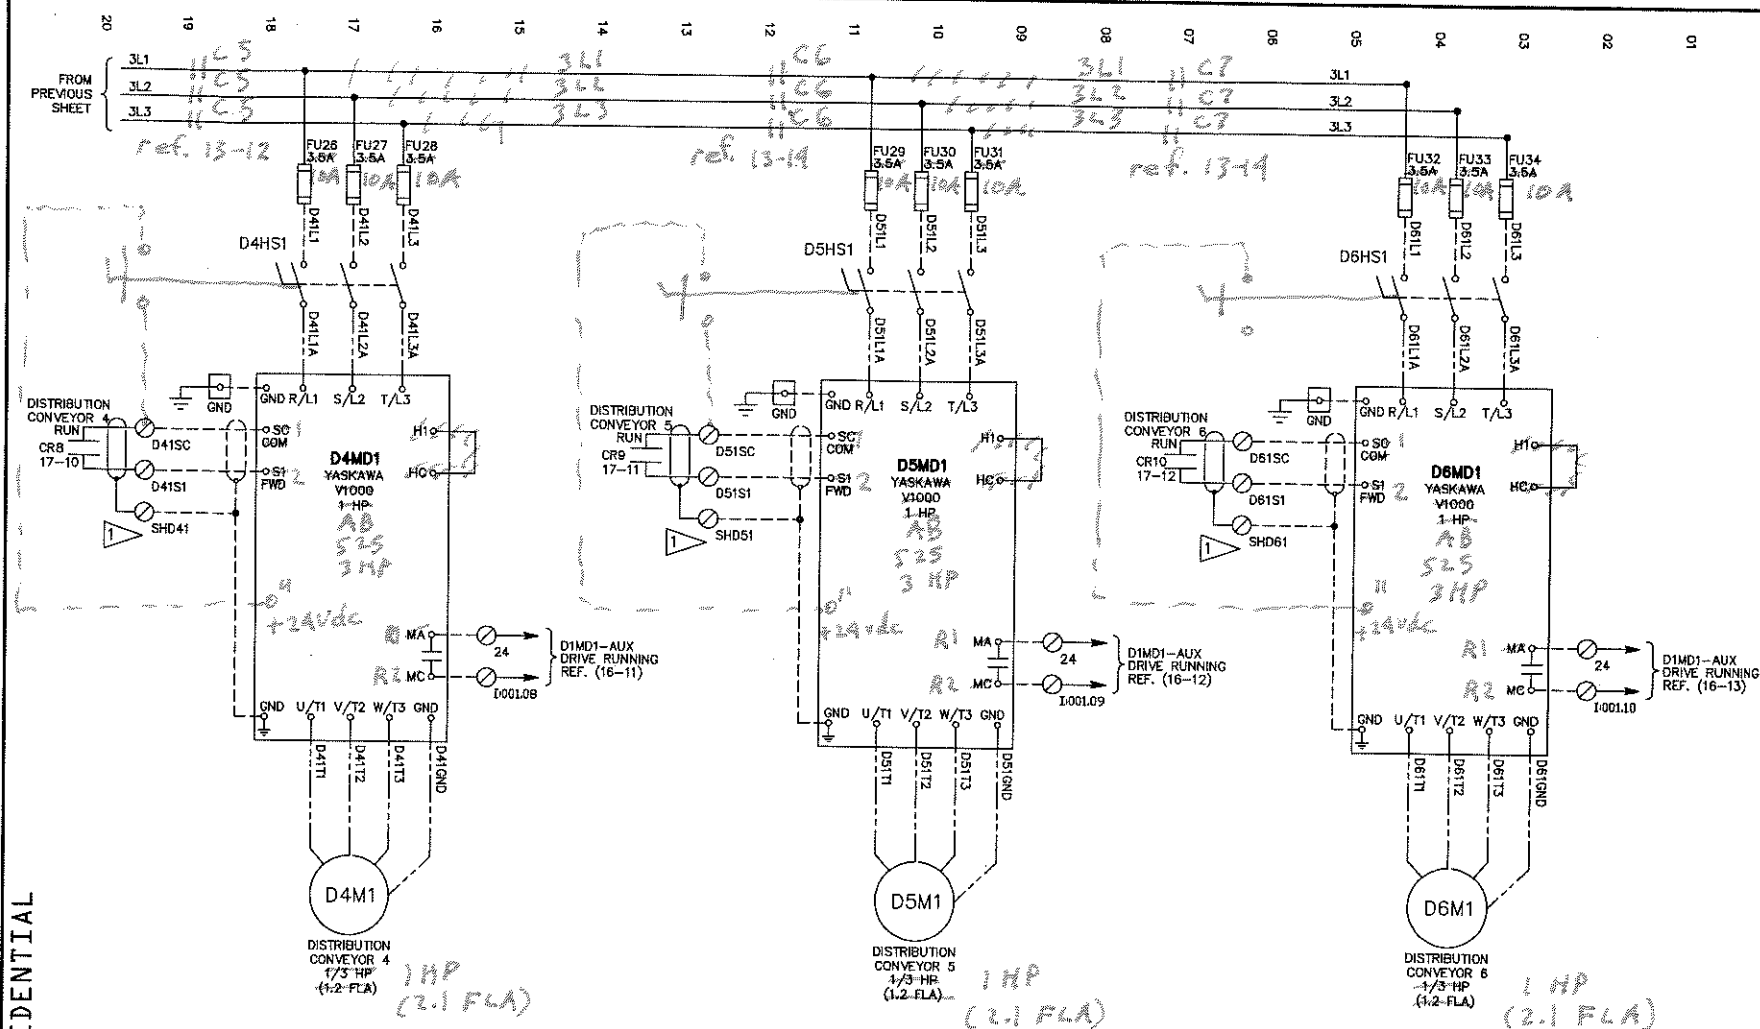

CONFIDENTIAL

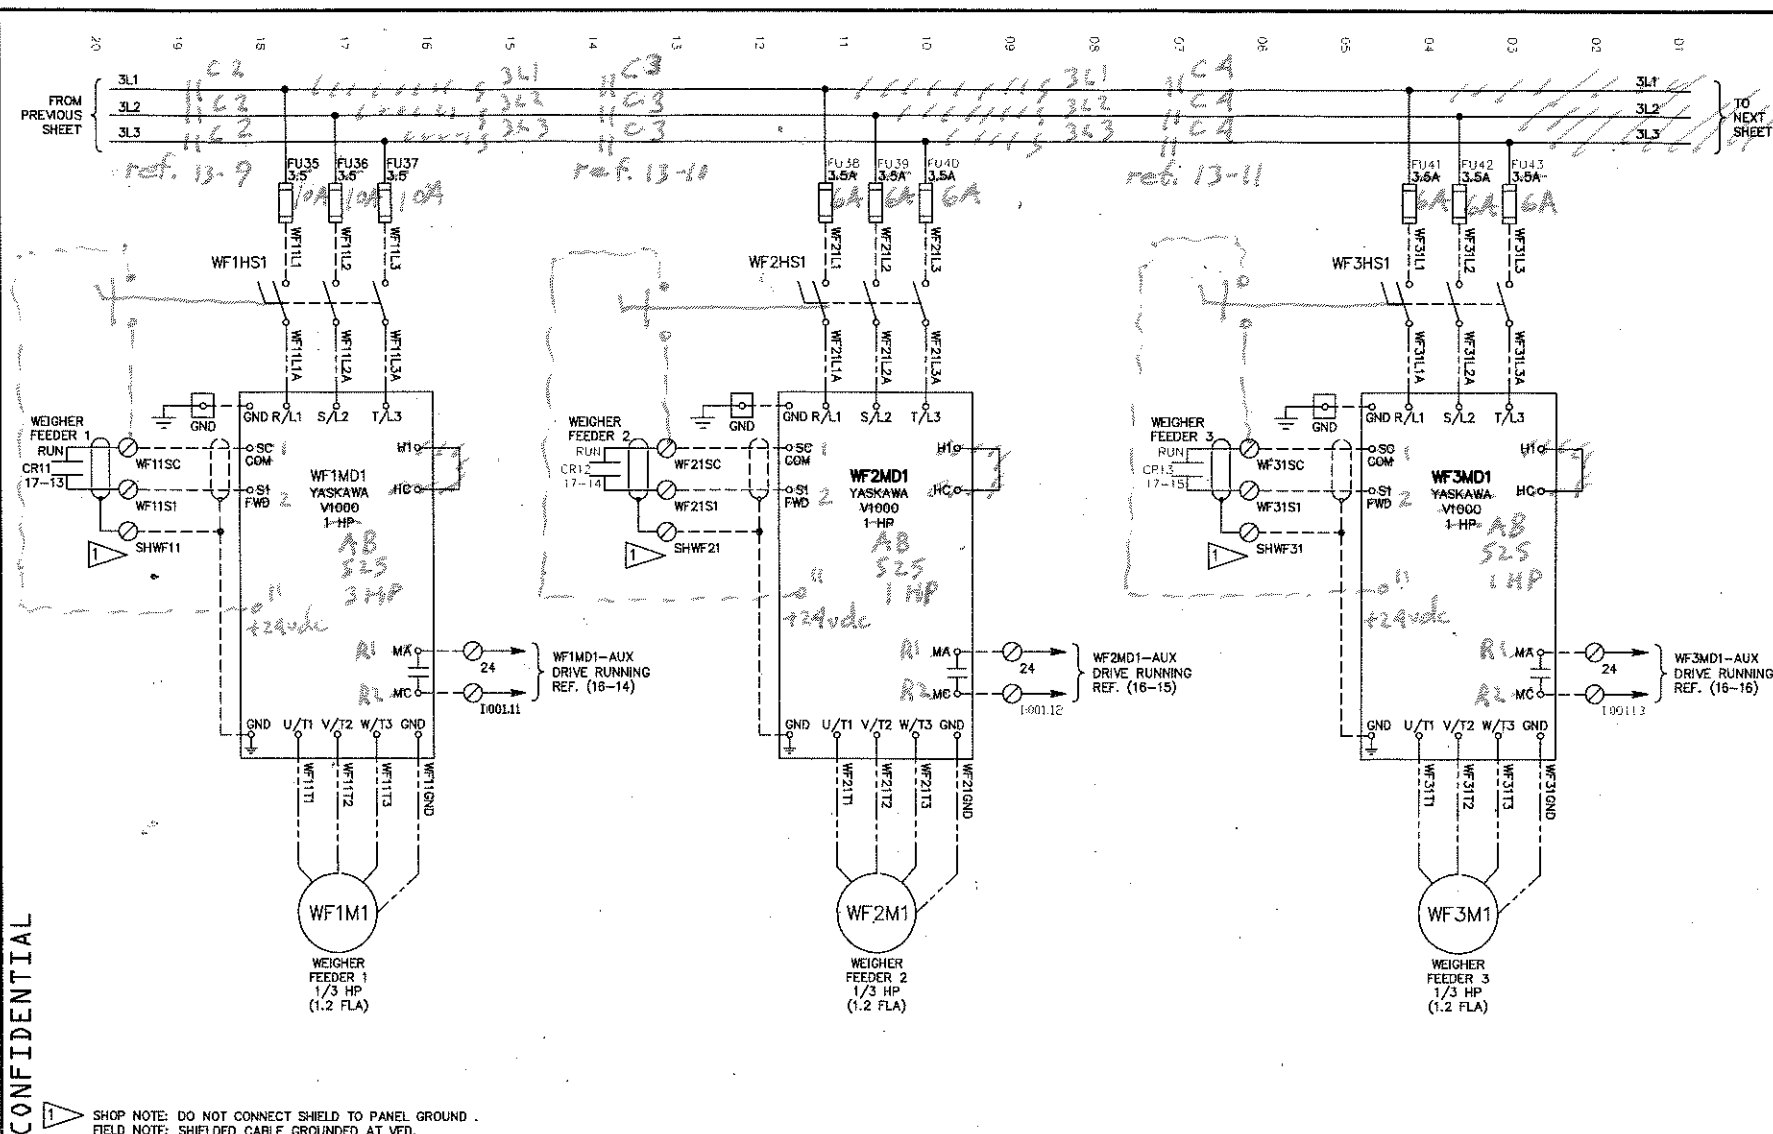

ALL RIGHTS OF DESIGN
OR INVENTION ARE RESERVED.

POWER DISTRIBUTION
WEIGHER FEEDER 1, 2 & 3
MAIN CONTROL PANEL - CPL
WEIGHER INFEED CONTROL STATION


DESIGNED BY
PABLO REYES
DRAWING BY
ALDO REYES
CHECKED BY
SCALE
NONE
DATE
May 23, 2024

NOTES:

SHEET

11

CONFIDENTIAL

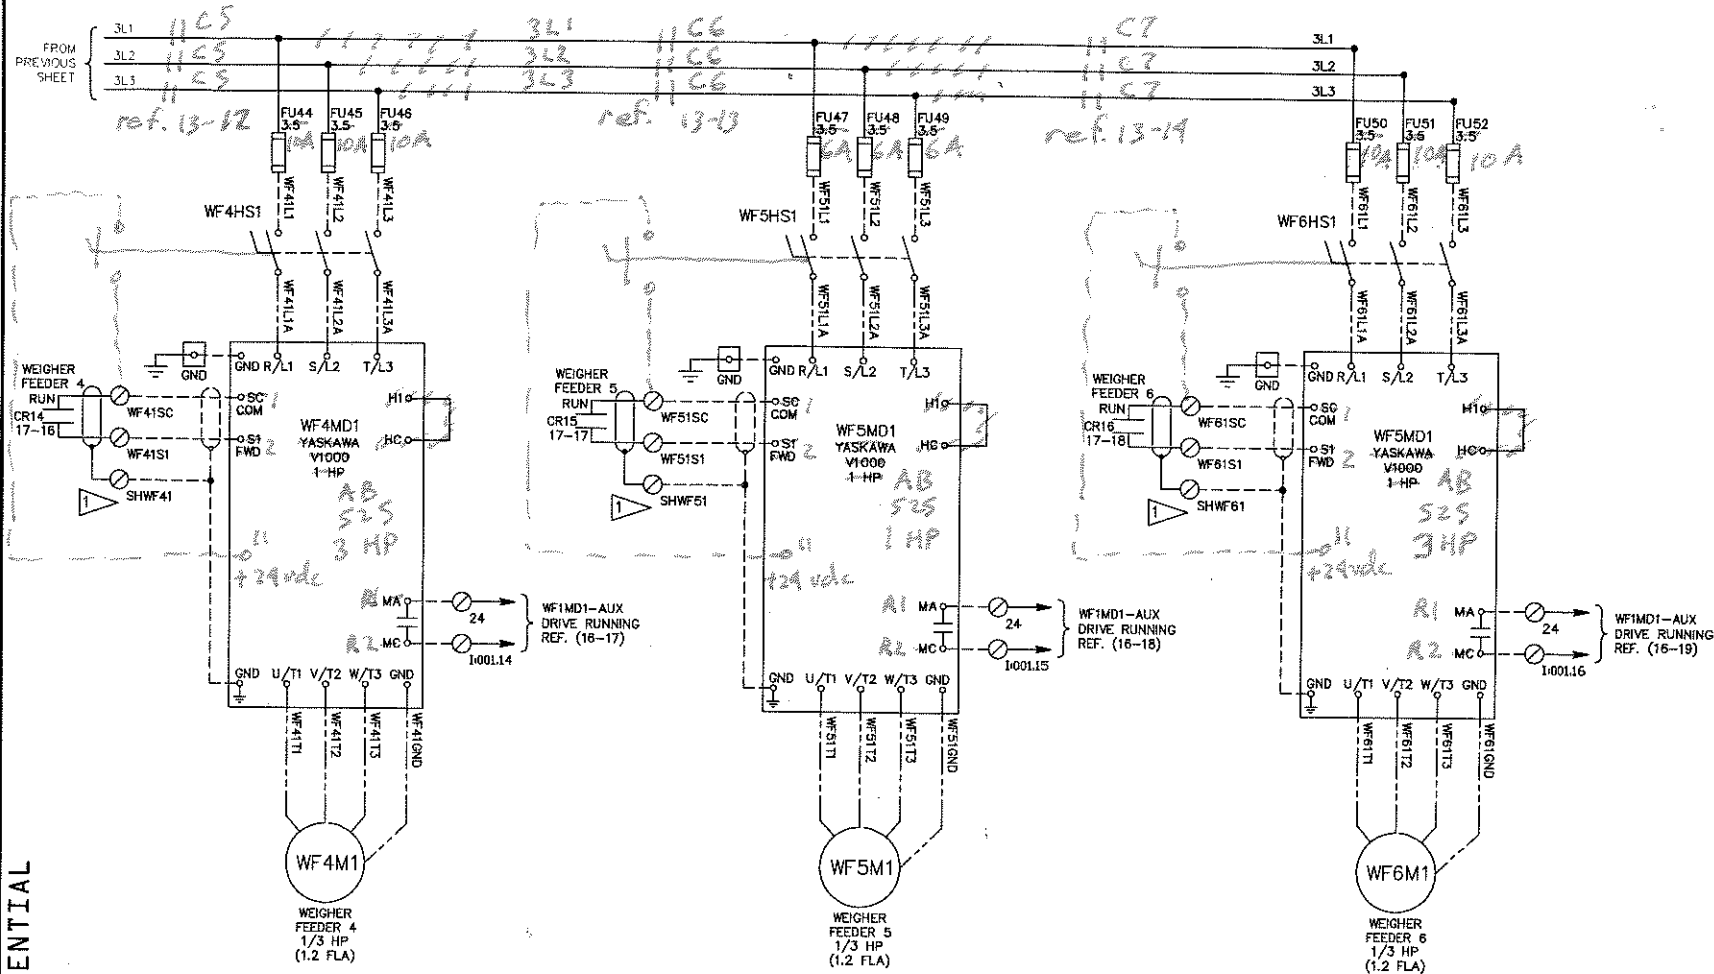

ALL RIGHTS OF DESIGN
OR INVENTION ARE RESERVED.


POWER DISTRIBUTION
WEIGHER FEEDER 4, 5 & 6
MAIN CONTROL PANEL - CP1
WEIGHER INFEED CONTROL STATION

DESIGNED BY
PABLO REYES
DRAWING BY
ALDO REYES
CHECKED BY
SCALE
NONE
DATE
May 23, 2024

NOTES:

SHEET

12

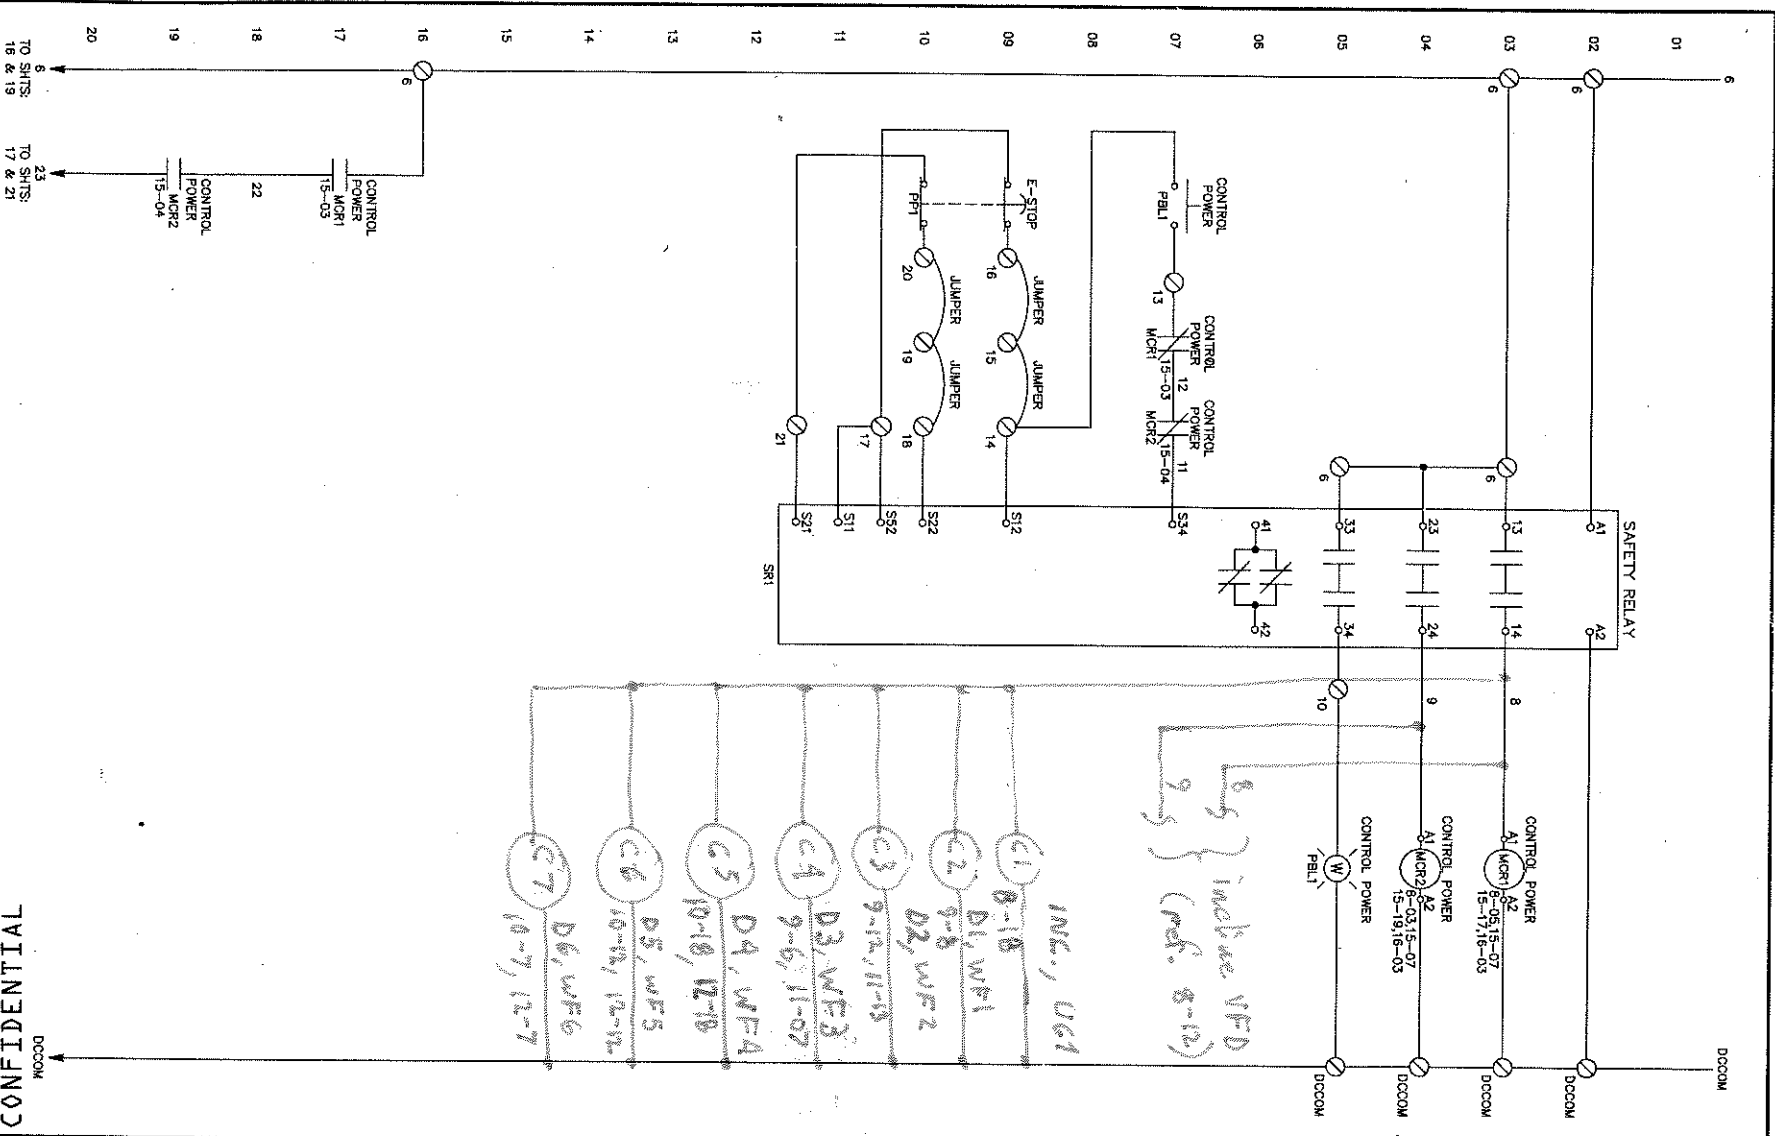

CONFIDENTIAL


ALL RIGHTS OF DESIGN
OR INVENTION ARE RESERVED.

CONTROL SCHEMATIC
SAFETY RELAY & CONTROL POWER
MAIN CONTROL PANEL - CPI
WEIGHER INFEEED CONTROL STATION

NOTES:

SHEET
13

DESIGNED BY
PABLO REYES
DRAWING BY
ALDO REYES
CHECKED BY
SCALE
NONE
DATE
May 23, 2024

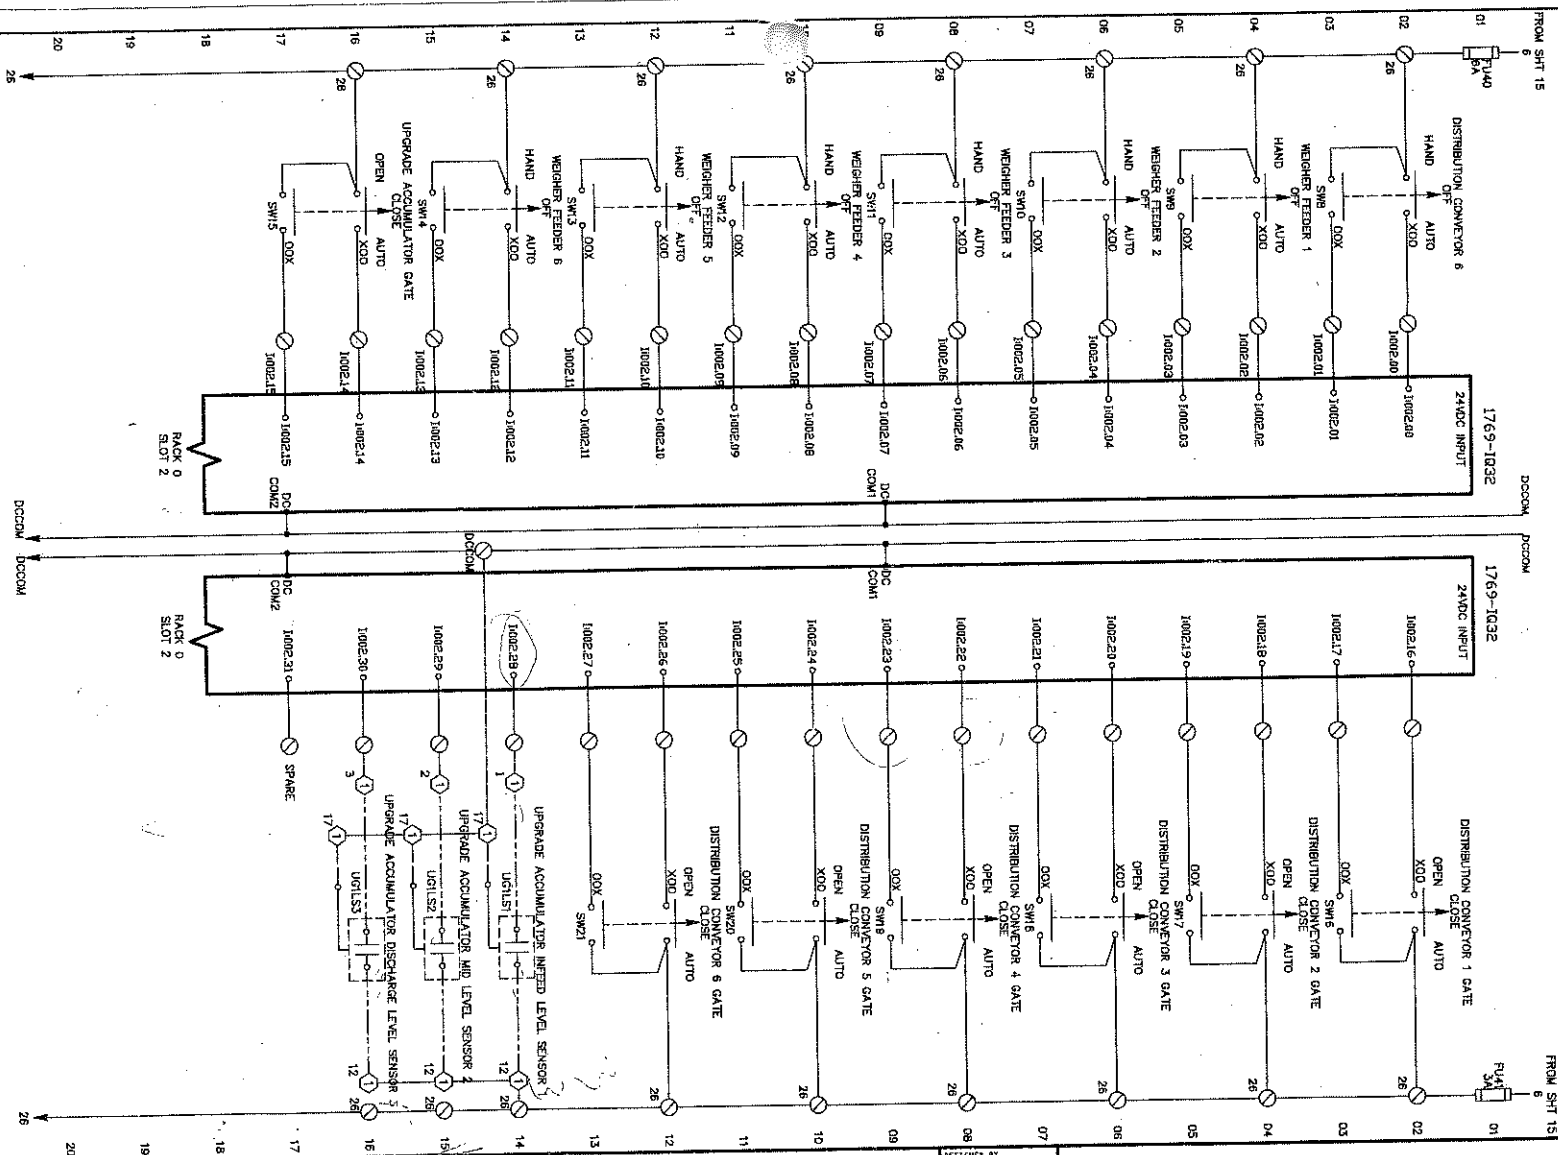

NOTES:

DESIGNED BY
PABLO REYES
DRAWING BY
ALDO REYES
CHECKED BY
SCALE
NONE
DATE
May 23, 2024


CONTROL SCHEMATIC
24VDC DIGITAL INPUT, RACK D, SLOT 2
MAIN CONTROL PANEL - CPl
WEIGHER INFED CONTROL STATION

SHEET

15

CONFIDENTIAL

ALL RIGHTS OF DESIGN
OR INVENTION ARE RESERVED.

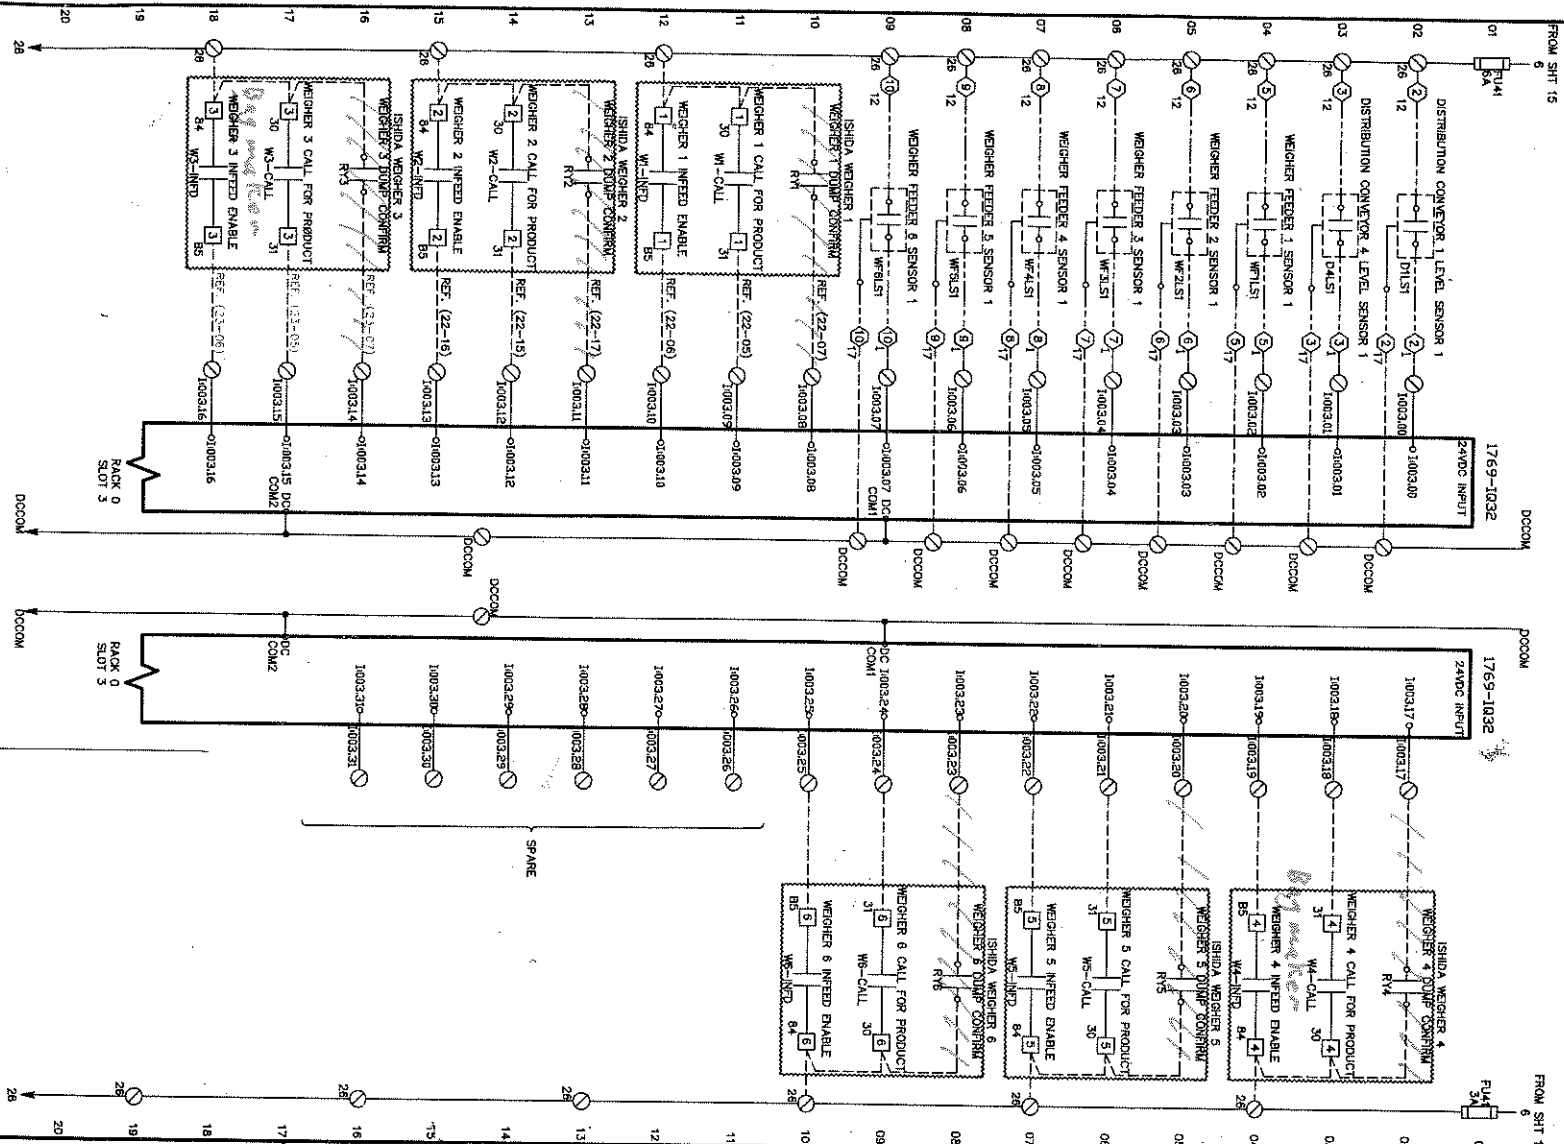


NOTES:

DESIGNED BY
PABLO REYES
DRAWING BY
ALDO REYES
CHECKED BY
SCALE
NONE
DATE
May 23, 2024

CONTROL SCHEMATIC
24VDC DIGITAL INPUT, RACK D, SLOT 3
MAIN CONTROL PANEL - CPl
WEIGHER INFED CONTROL STATION

ALL RIGHTS OF DESIGN
OR INVENTION ARE RESERVED.

CONFIDENTIAL

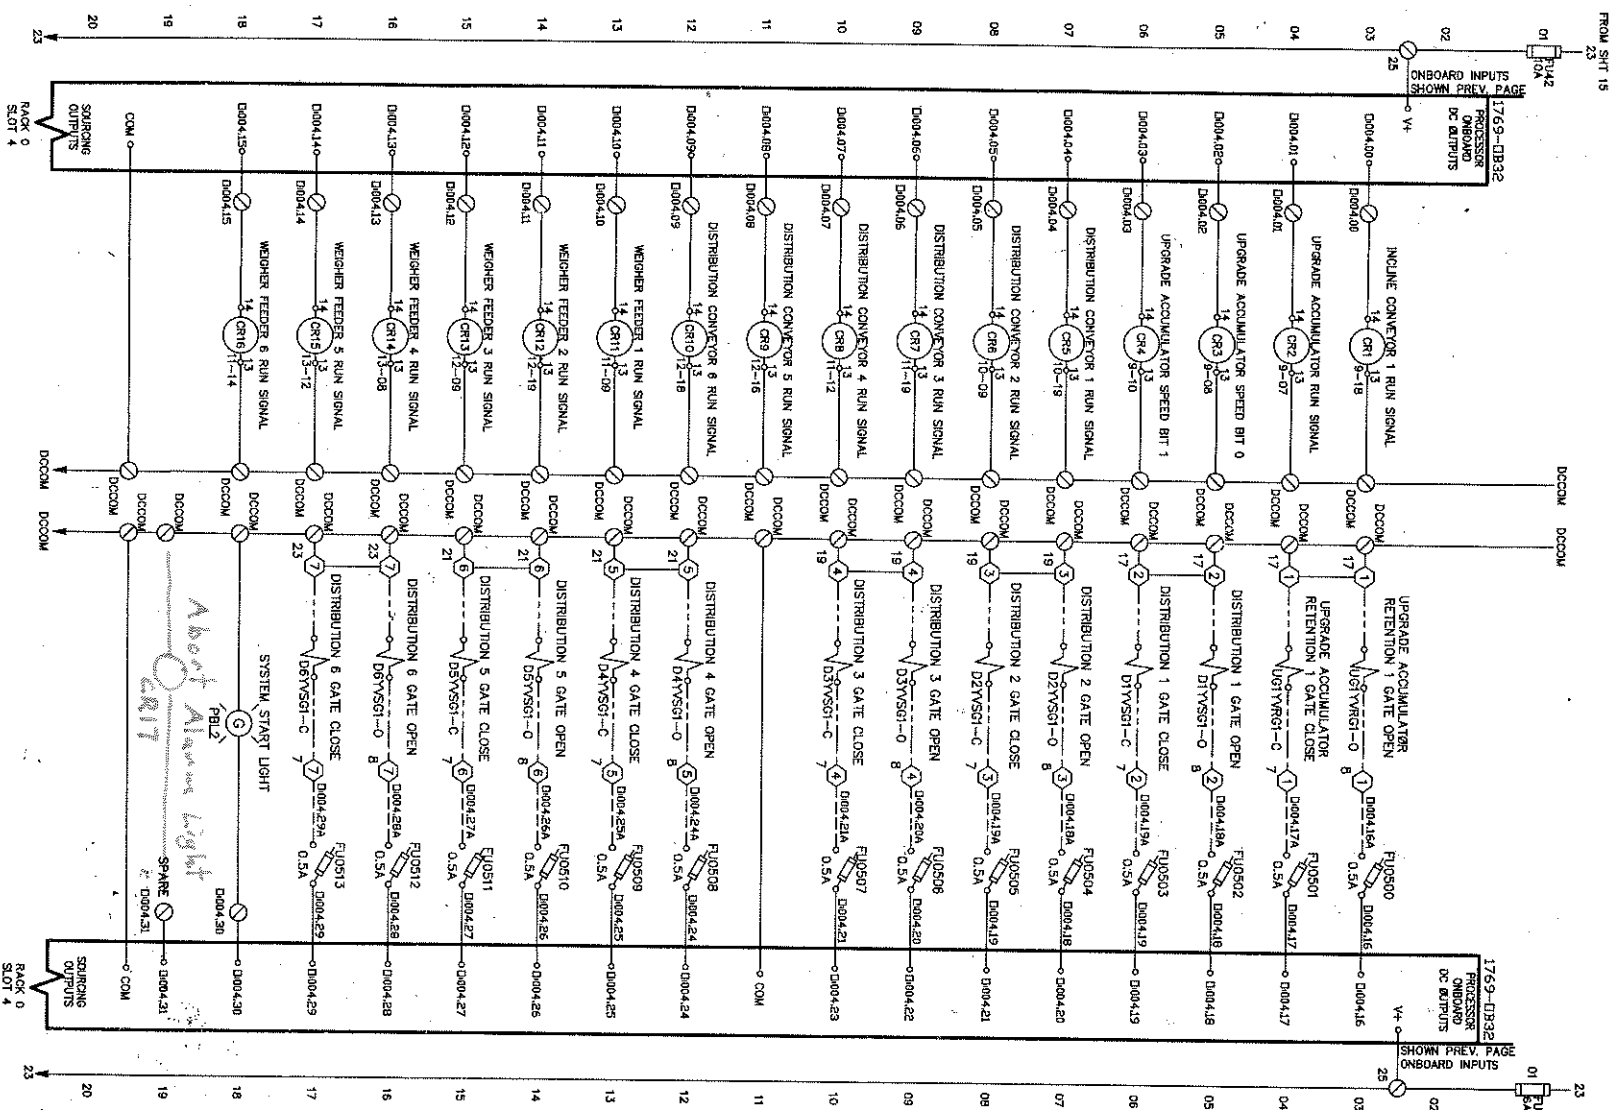

CONFIDENTIAL

ALL RIGHTS OF DESIGN
OR INVENTION ARE RESERVED.



CONTROL SCHEMATIC
24VDC DIGITAL INPUT, RACK 0, SLOT 4
MAIN CONTROL PANEL - CPI
WEIGHER INFEED CONTROL STATION

DESIGNED BY
PAUL D. REYES
DRAWING BY
ALDO REYES
CHECKED BY
SCALE
NONE
DATE
May 23, 2024



NOTES:

SHEET
17



ISHIDA WEIGHER 1

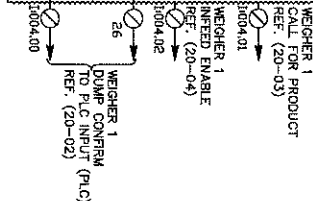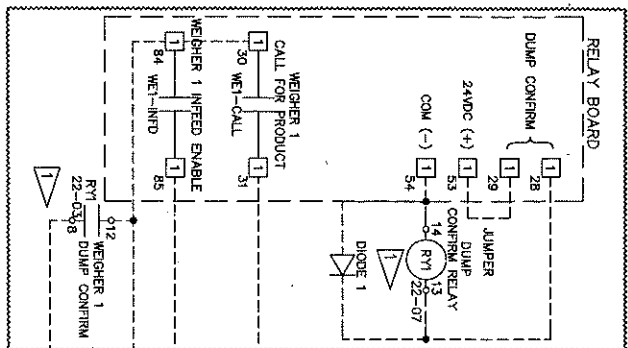

ISHIDA WEIGHER 2

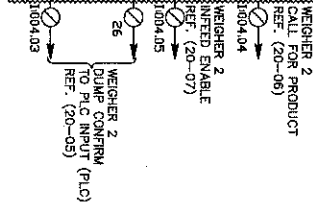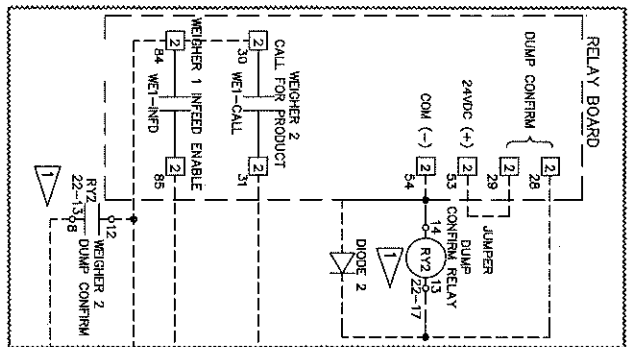

ISHIDA WEIGHER 3

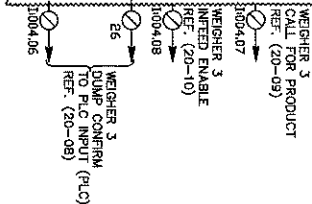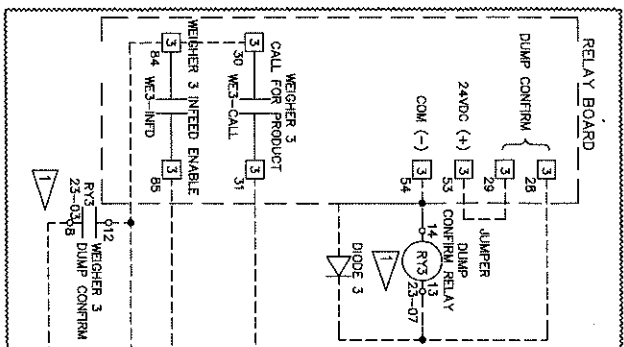

SHEET

18

NOTES:



DESIGNED BY
PABLO REYES
DRAWING BY
ALDO REYES
CHECKED BY
SCALE
NONE
DATE
May 23, 2024

CONTROL SCHEMATIC
WEIGHER RELAY BOARD 1, 2 & 3
MAIN CONTROL PANEL - CPL
WEIGHER INFED CONTROL STATION

ALL RIGHTS OF DESIGN
OR INVENTION ARE RESERVED.

CONFIDENTIAL

RELAY & DIODE TO BE SHIPPED LOOSE FOR INSTALLATION ONSITE.

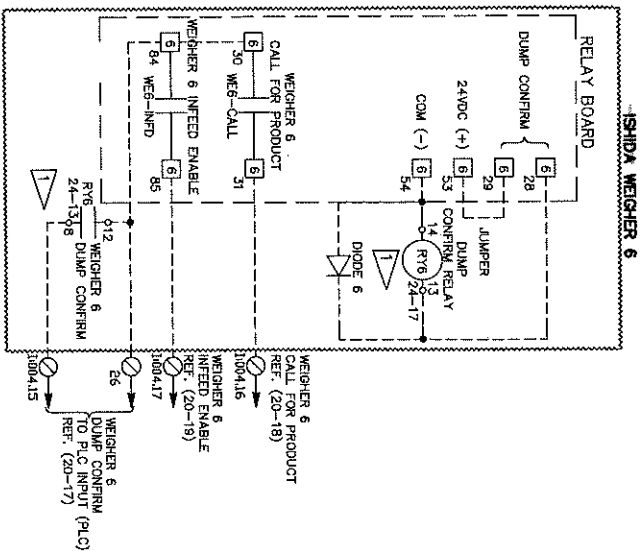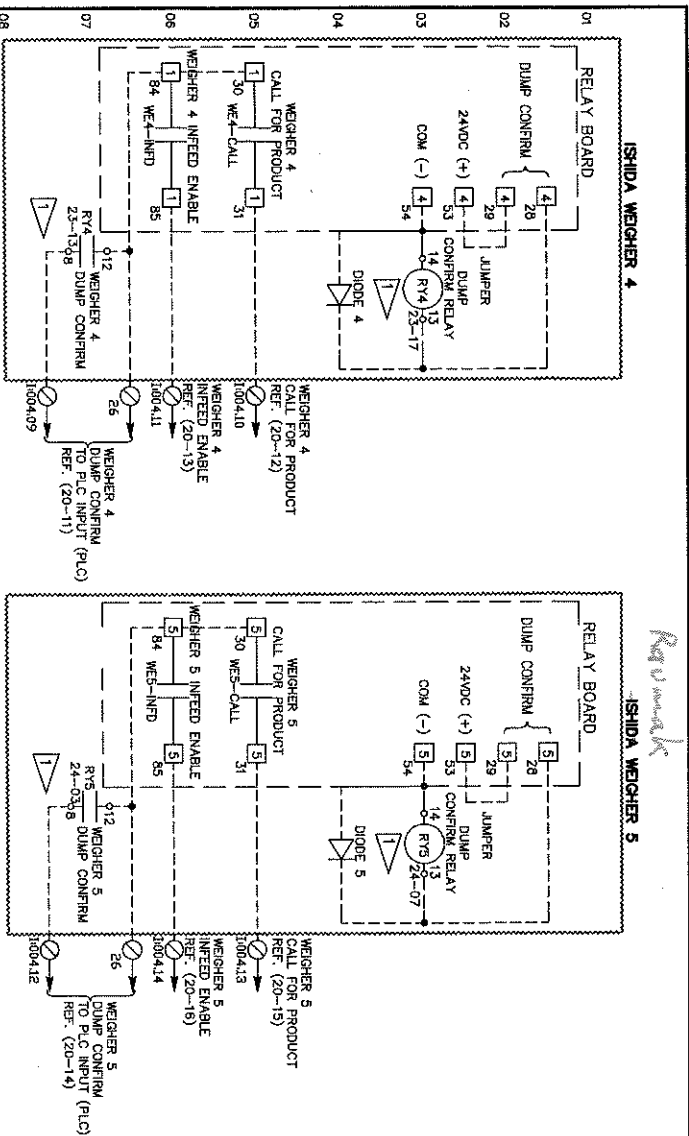

SHEET

19

NOTES:

DESIGNED BY
 PABLO REYES
 DRAWING BY
 ALDO REYES
 CHECKED BY
 SCALE
 NONE
 DATE
 May 23, 2024

CONTROL SCHEMATIC
 WEIGHER RELAY BOARD 4, 5 & 6
 MAIN CONTROL PANEL - CP1
 WEIGHER INFEED CONTROL STATION

ALL RIGHTS OF DESIGN
 OR INVENTION ARE RESERVED.

CONFIDENTIAL

RELAY & DIODE TO BE SHIPPED LOOSE FOR INSTALLATION ONSITE.