
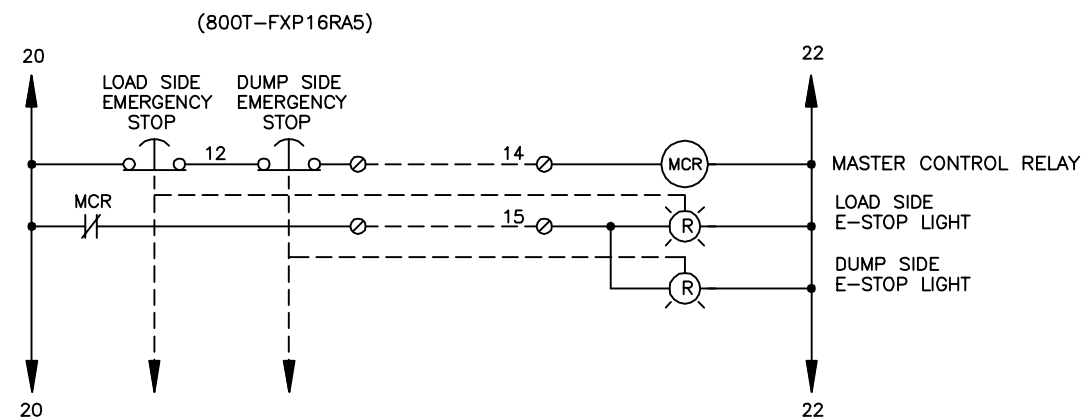
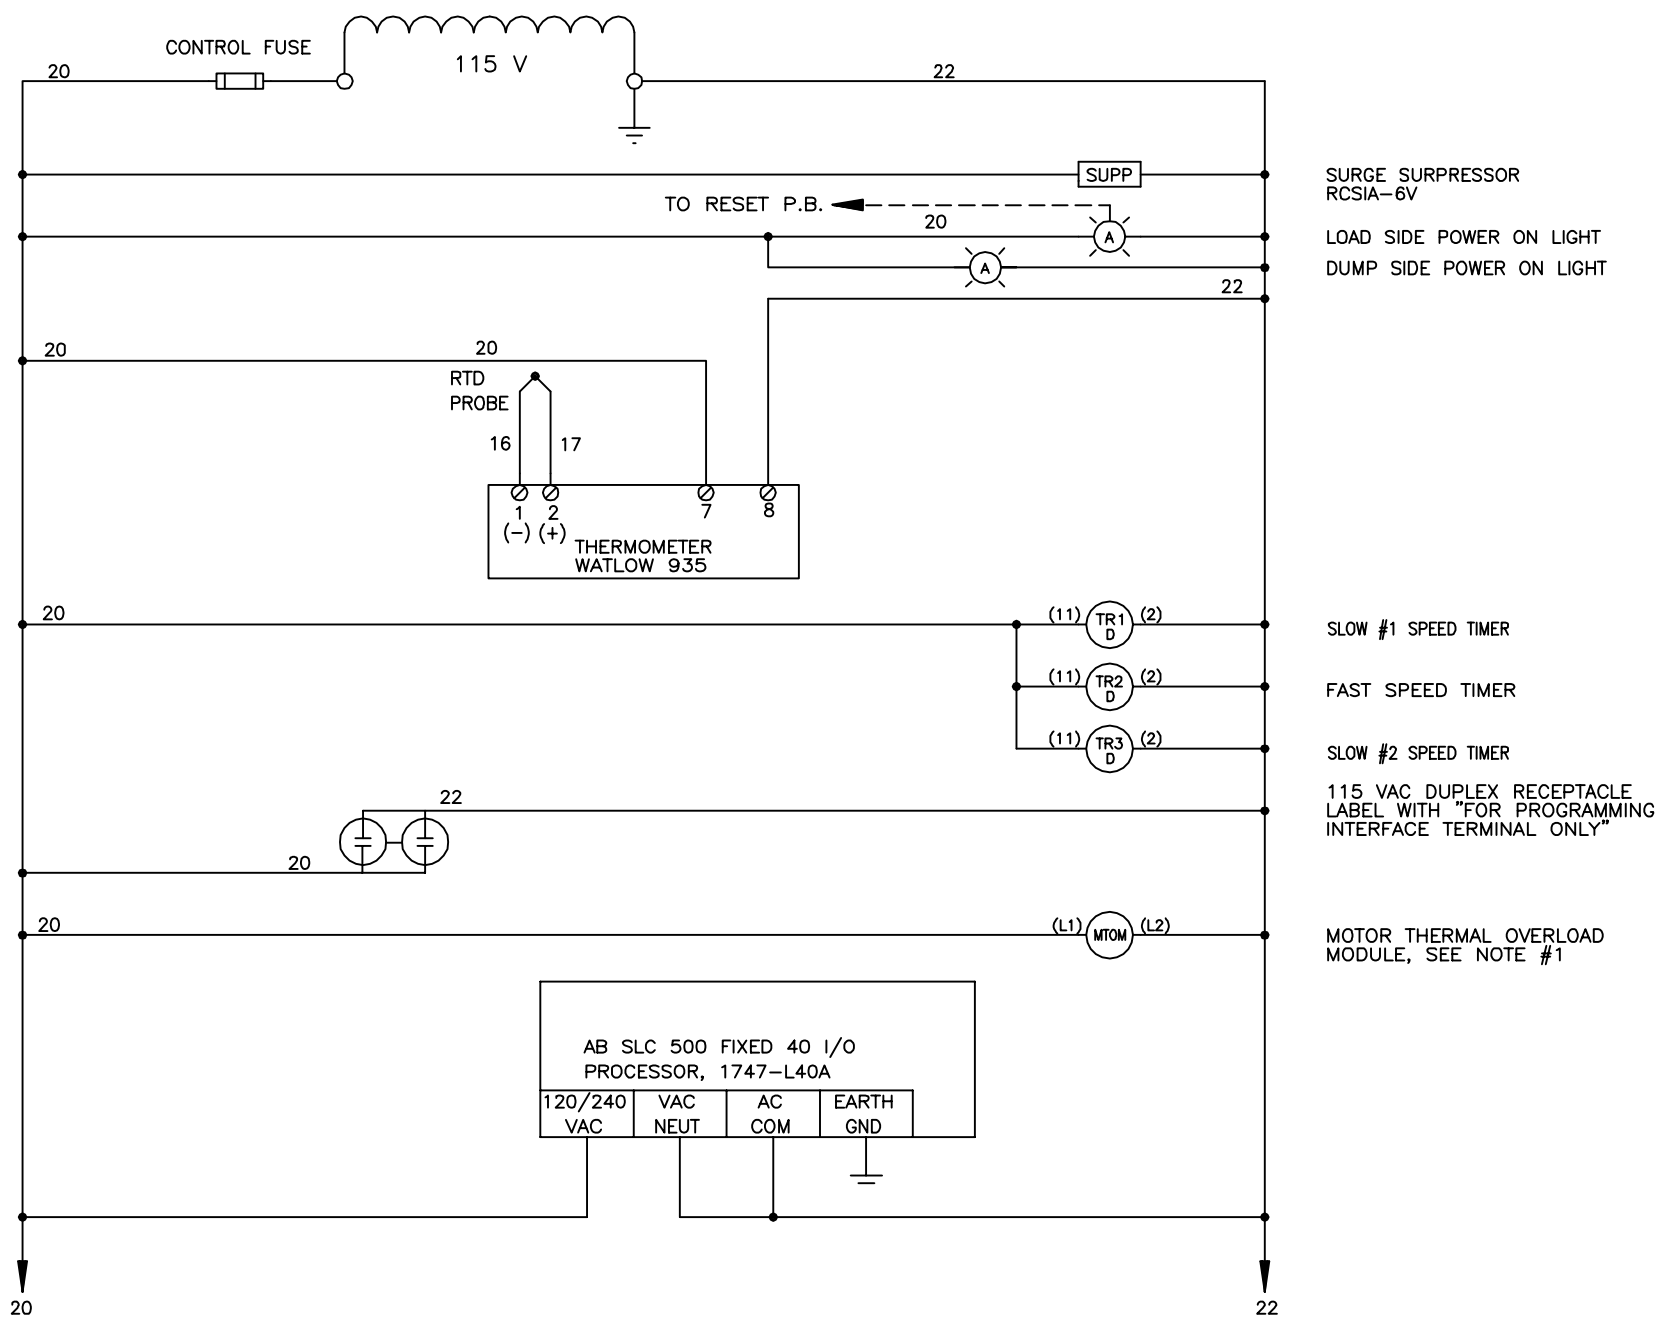


DATE	REV	REVISION (+ ADD, - REMOVE, ± WAS)	DCR No.	DR BY	OK BY
8/17/00	A	AS BUILT	7742	DD	DD

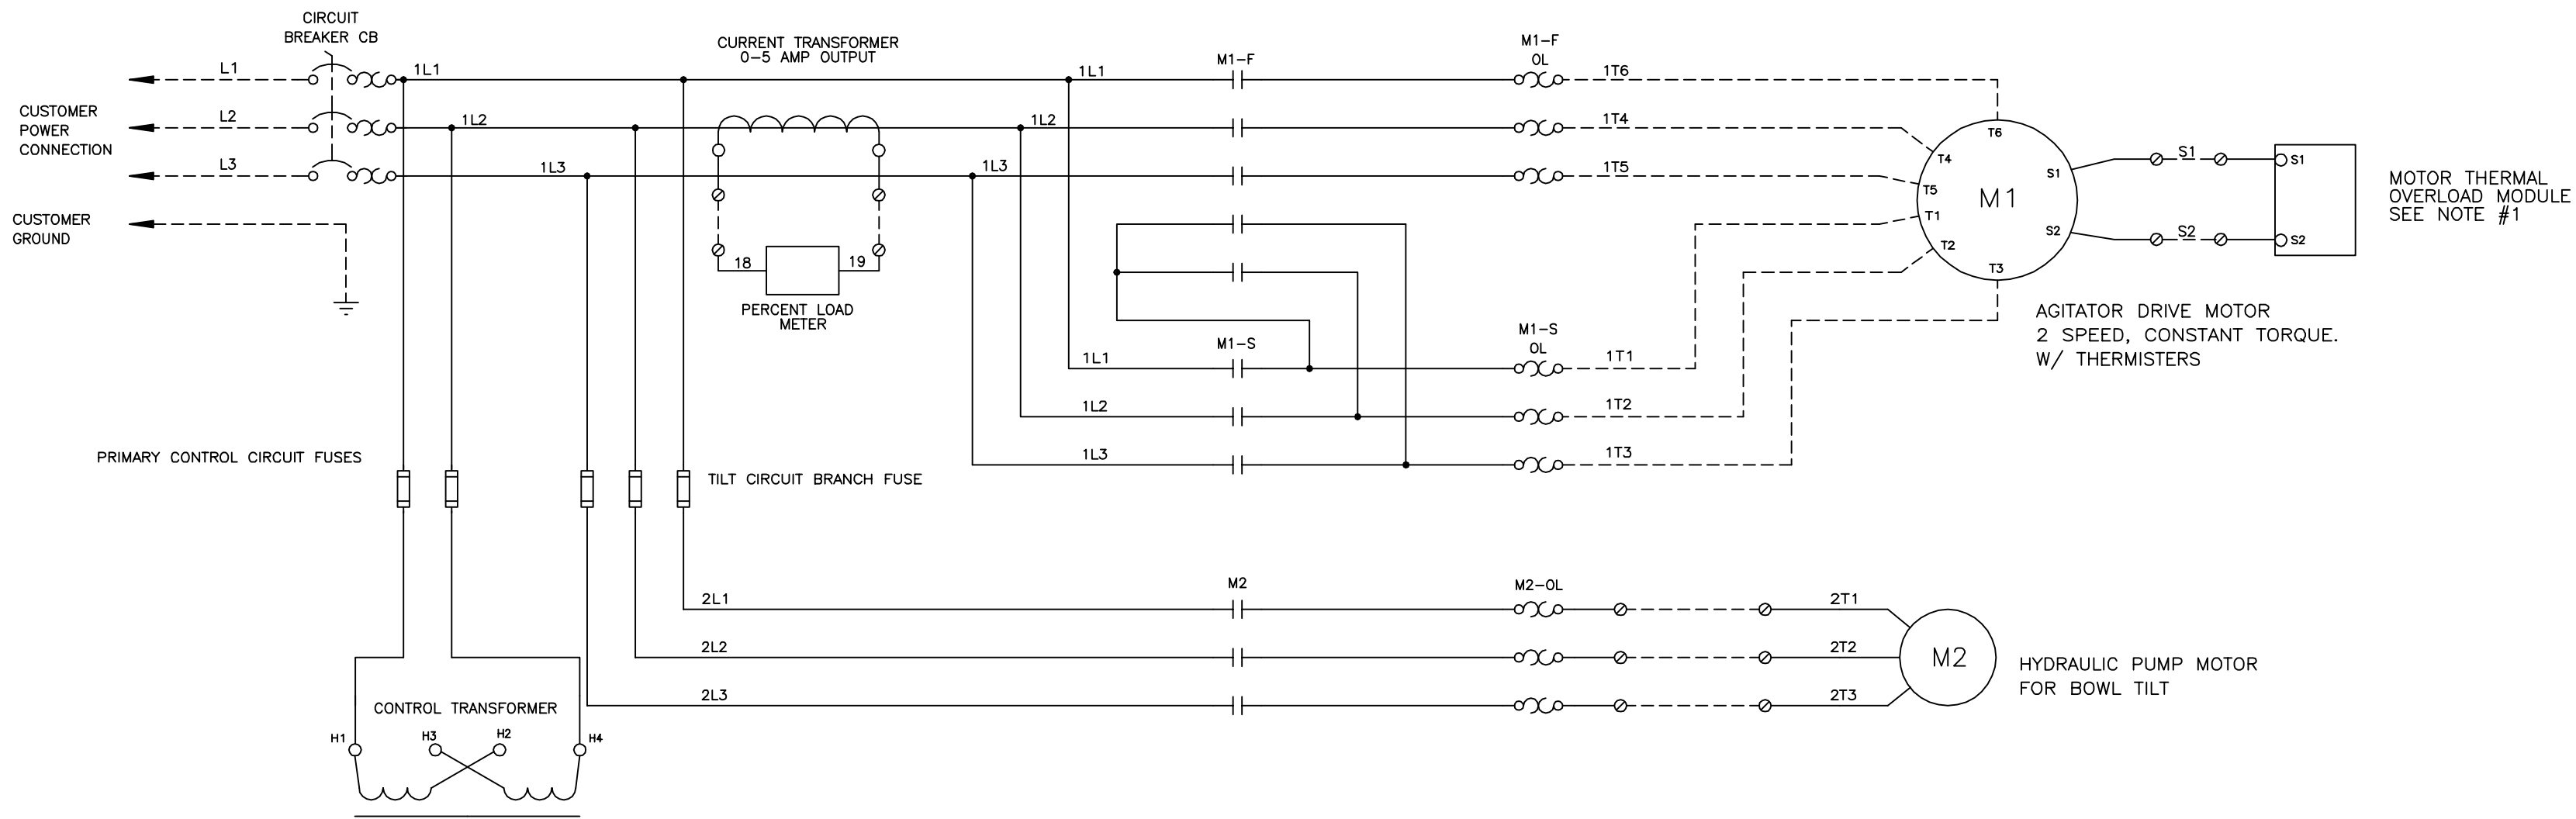

NOTES:

- 1) THE MOTOR THERMAL OVERLOAD MODULE IS CONNECTED TO THERMISTORS BURIED IN THE MOTOR WINDINGS. WHEN POWER IS APPLIED TO THE MODULE, THE CONTACTS ARE CLOSED. IF MOTOR OVERHEATS, THE MODULE TRIPS, OPENING THE CONTACTS. THE MODULE IS RESET BY REMOVING CONTROL POWER.
- 2) $\emptyset$ = TERMINAL CONNECTIONS
--- = CUSTOMER RUN WIRES
- 3) COLOR CODE:
WIRE NO. 20 AND 21 - YELLOW GROUND - GREEN
WIRE NO. 22 AND 23 - WHITE HIGH VOLTAGE - BLACK
ALL OTHERS - RED
- 4) TIMERS USED ARE EAGLE DIGITAL MODEL NO. CX202A6. THEY ARE PROGRAMMED WITH DIP SWITCHES LOCATED BEHIND FACE SET SWITCHES 1,2,3,6,7 TO "ON" AND 4,5 TO "OFF"

TERMINAL STRIP CONNECTIONS

REMOTE ENCLOSURE

14	15	18	19	20
20	21	22	23	25
23	30	31	32	33
34	35	36	37	38
39	40	41	42	43
44	45	46	47	48
49	50	51	52	53
60	61	62	63	64
65	66	67	68	69
70	71	72	73	74
75	M1	M33	211	
212	213	GND	A	
B	C			

60 TERMINAL BLOCKS

REAR COLUMN

12	14	15	16	17
18	19	20	20	20
22	22	23	23	28
30	31	32	33	35
36	37	38	39	40
41	42	43	44	45
47	48	49	50	51
52	53	60	61	64
65	67	68	72	73
74	75	211	212	
213	GND	A	B	C
D	E	F	GRN	BLK
RED				

61 TERMINAL BLOCKS

FRONT CONTROL PANEL

12	14	15	20	22
28	30	47	48	49
50	51	64	74	75
D	E	F		

23 TERMINAL BLOCKS

REAR CONTROL PANEL

12	15	16	17	18
19	20	22	28	31
32	35	36	37	38
39	40	52	53	65
67	72	73	74	75
GRN	BLK	RED	GND	

29 TERMINAL BLOCKS

CUSTOMER TO CONNECT THESE
TWO TERMINAL STRIPS, 43 WIRES
□ DENOTES WIRES TO CONNECT
M1 AND M33 RUN TO DRIVE MOTOR JUNCTION BOX

PEERLESS MACHINERY CORPORATION SIDNEY, OHIO			
TOLERANCES (UNLESS OTHERWISE SPECIFIED) DECIMAL .XX = ±0.1 ANGLES ±1° FRACTIONAL ±1/32 .XXX = ±0.05 BREAK ALL EDGES			
MATERIAL	DRAWN BY D. DIXON		
FOR CMO 200022 & 200023		APPROVED BY W. Fowler	
SCALE	TITLE MOTOR CONTROL DIAG. 2 SP. DIGITAL, HYD. W/O REFRIG.		
DATE 5/17/00	DRAWING NUMBER WTB-1398	FILE NUMBER WD19-81	