
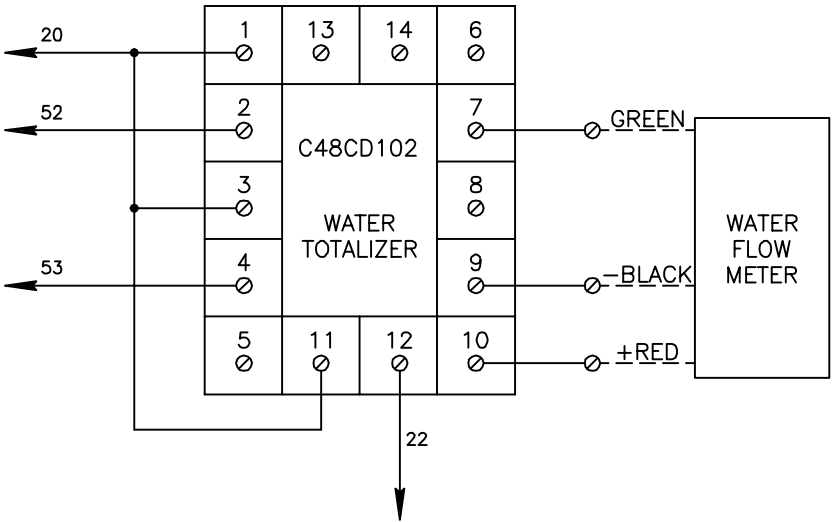


DATE	REV	REVISION (+ ADD, - REMOVE, ±WAS)	DCR	DR BY	OK BY
8/17/00	A	AS BUILT	7743	DD	DD

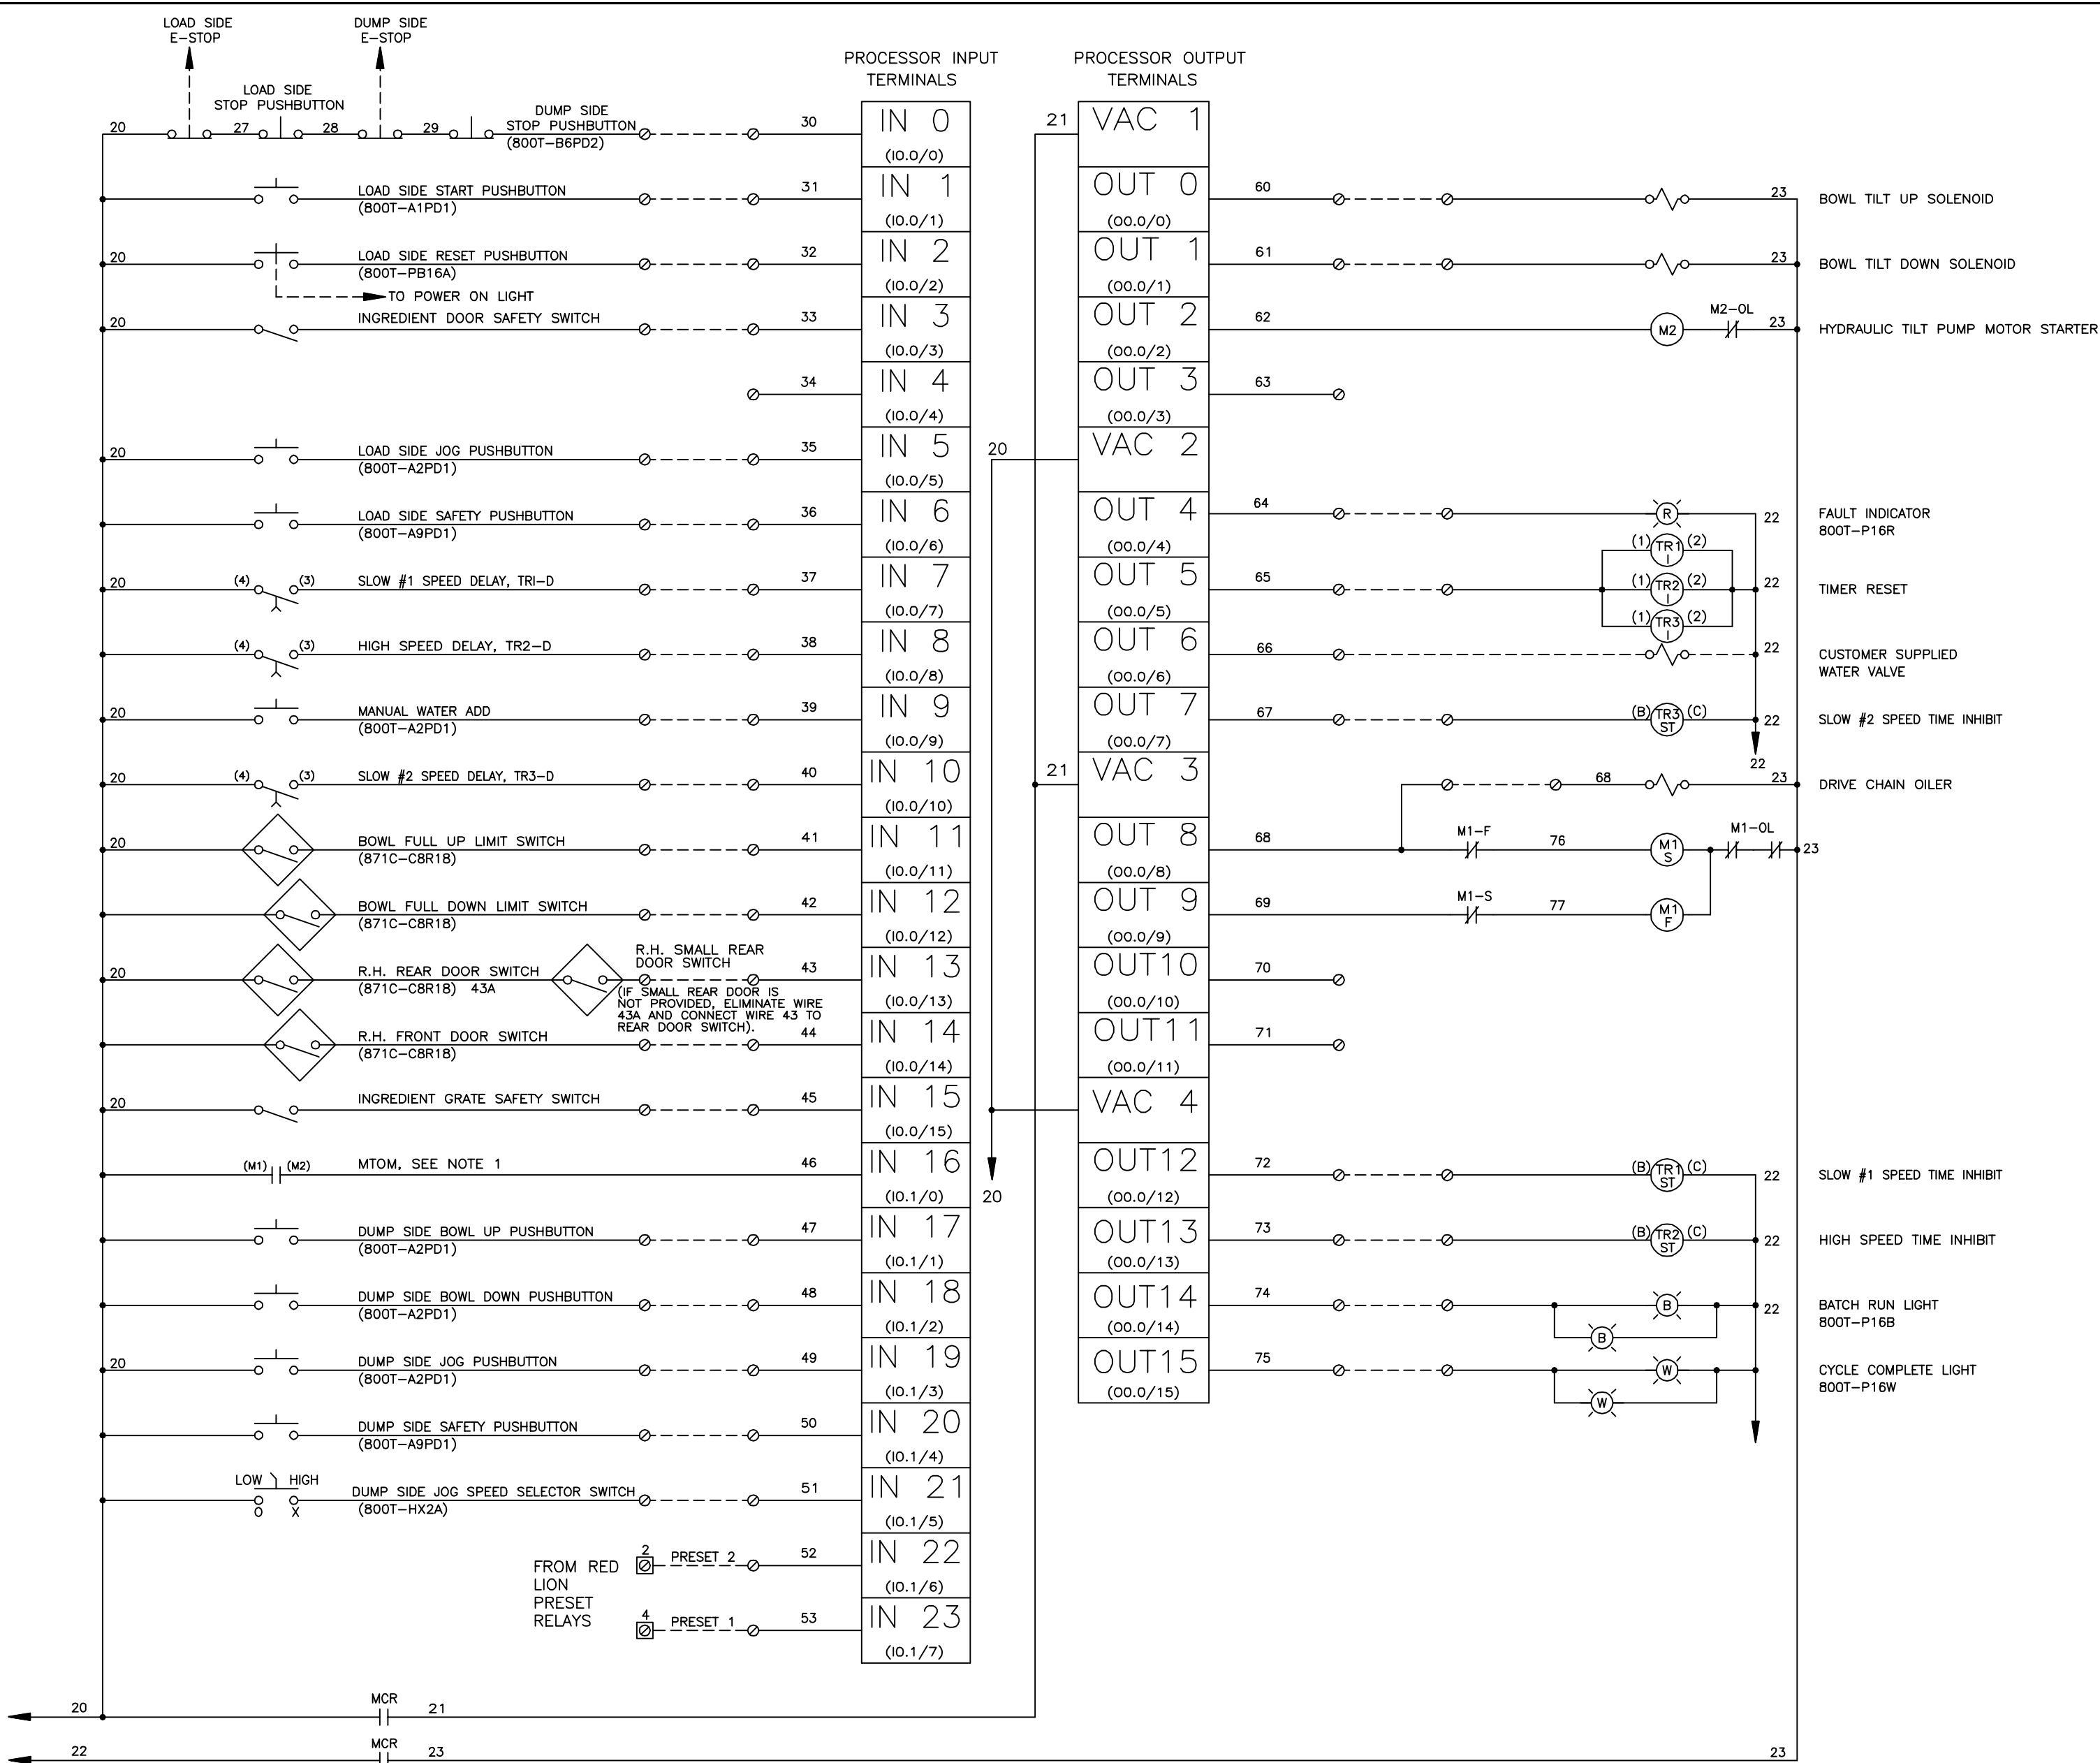

I/O WIRING INSTRUCTION:
 RUN 16 GA WIRE FROM I/O TERMINAL
 TO TERMINAL STRIP ENCLOSURE.
 ALL I/O CONNECTIONS MUST RUN TO A
 TERMINAL BLOCK.

WARNING:
 IF SAFETY INGREDIENT DOOR IS SUPPLIED,
 THE INGREDIENT DOOR SAFETY SWITCH MUST
 WORK AT ALL TIMES. SEVERE PERSONAL
 INJURY MAY RESULT IF IT DOES NOT.

	PEERLESS MACHINERY CORPORATION SIDNEY, OHIO		
TOLERANCES (UNLESS OTHERWISE SPECIFIED)			
DECIMAL .XX= ±0.1		ANGLES ±1°	
.XXX= ±0.05		FRACTIONAL ±1/32	
		BREAK ALL EDGES	
MATERIAL	FOR CMO 200022 & 200023		DRAWN BY D. DIXON
SCALE			APPROVED BY TEQUER
TITLE			
---			INPUT/OUTPUT SCHEMATIC
			SLC-500 REFRIG.
DATE	DRAWING NUMBER	FILE NUMBER	
5/17/00	WTB-1399	WD19-82	