


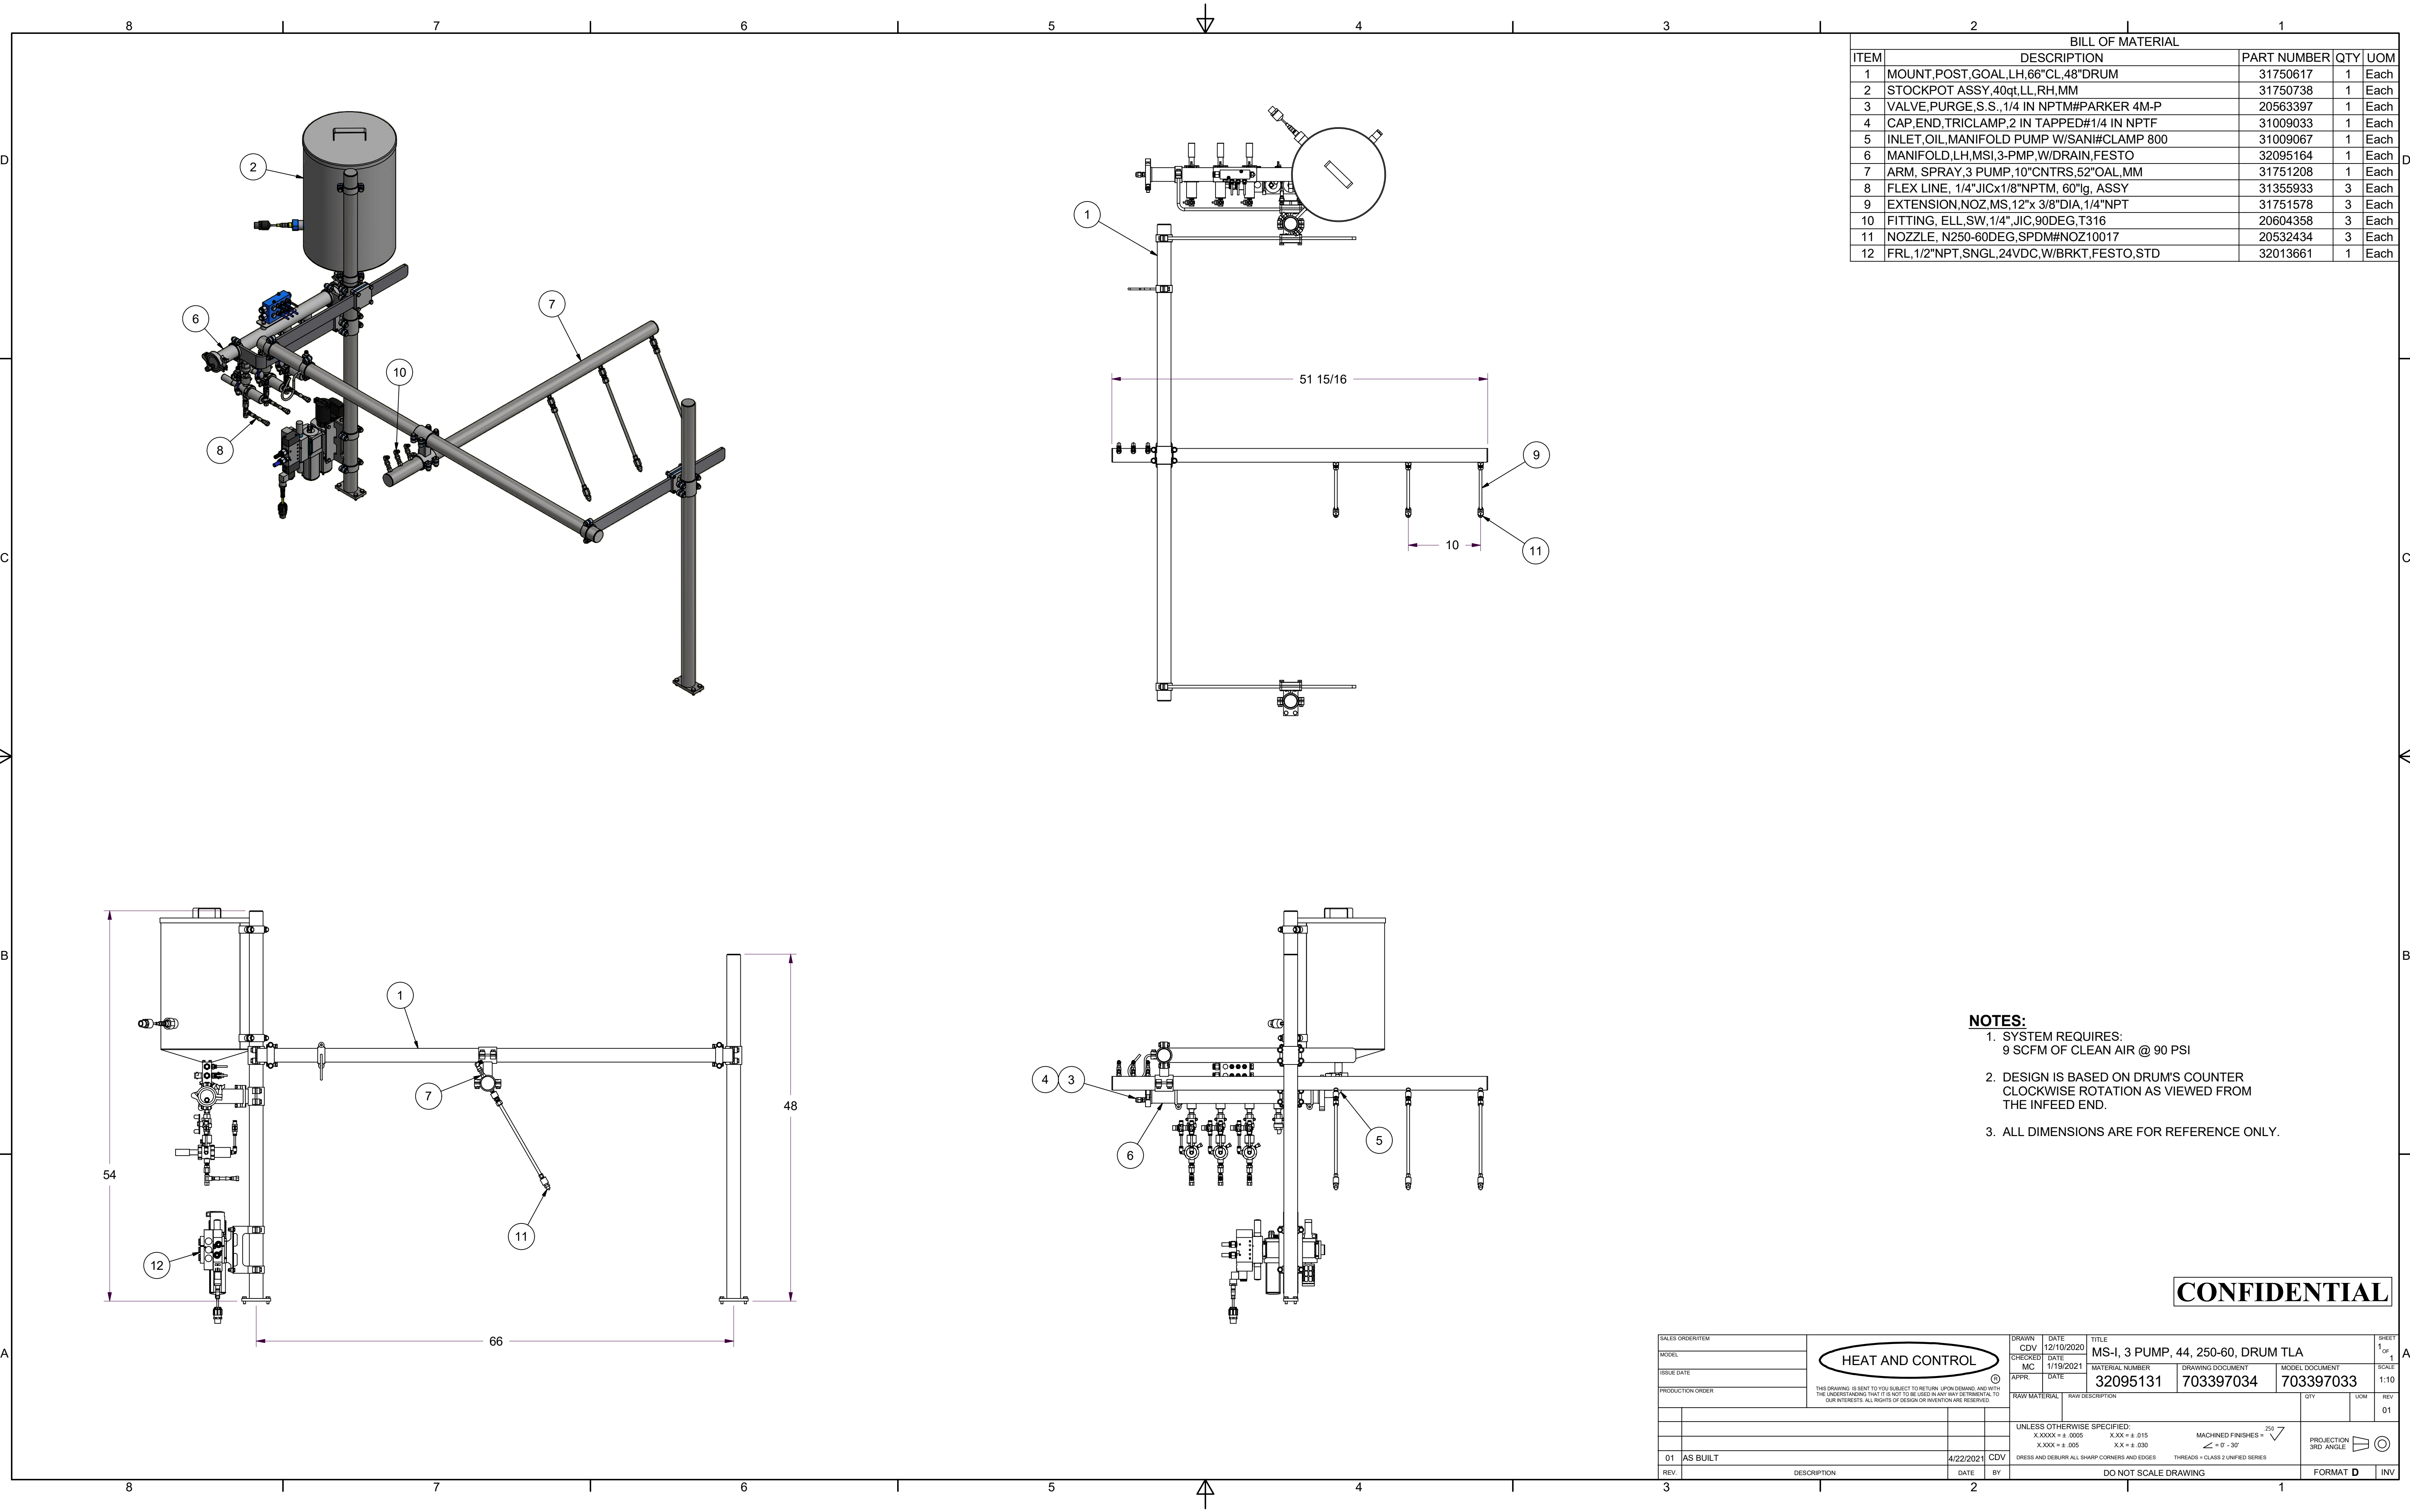

BILL OF MATERIAL					
ITEM	DESCRIPTION	PART NUMBER	QTY	UOM	
1	MOUNT,POST,GOAL,LH,66"CL,48"DRUM	31750617	1	Each	
2	STOCKPOT ASSY,40qt,LL,RH,MM	31750738	1	Each	
3	VALVE,PURGE,S.S.,1/4 IN NPTM#PARKER 4M-P	20563397	1	Each	
4	CAP.END,TRICLAMP,2 IN TAPPED#1/4 IN NPTF	31009033	1	Each	
5	INLET,OIL,MANIFOLD PUMP W/SANI#CLAMP 800	31009067	1	Each	
6	MANIFOLD,LH,MSI,3-PMP,W/DRAIN,FESTO	32095164	1	Each	
7	ARM, SPRAY,3 PUMP,10"CNTRS,52"OAL,MM	31751208	1	Each	
8	FLEX LINE, 1/4"JICx1/8"NPTM, 60"lg. ASSY	31355933	3	Each	
9	EXTENSION,NOZ,MS,12"x 3/8"DIA,1/4"NPT	31751578	3	Each	
10	FITTING, ELL,SW,1/4",JIC,90DEG,T316	20604358	3	Each	
11	NOZZLE, N250-60DEG,SPDM#NOZ10017	20532434	3	Each	
12	FRL,1/2"NPT,SNGL,24VDC,W/BRKT,FESTO,STD	32013661	1	Each	

- NOTES:**
- 1. SYSTEM REQUIRES:
9 SCFM OF CLEAN AIR @ 90 PSI
 - 2. DESIGN IS BASED ON DRUM'S COUNTER
CLOCKWISE ROTATION AS VIEWED FROM
THE INFEED END.
 - 3. ALL DIMENSIONS ARE FOR REFERENCE ONLY.

CONFIDENTIAL

SALES ORDER/ITEM		DRAWN CDV DATE 12/10/2020		TITLE MS-I, 3 PUMP, 44, 250-60, DRUM TLA		SHEET 1 OF 1	
MODEL		CHECKED MC DATE 1/19/2021		MATERIAL NUMBER 32095131		SCALE 1:10	
ISSUE DATE		APPR. DATE		DRAWING DOCUMENT 703397034		MODEL DOCUMENT 703397033	
PRODUCTION ORDER		RAW MATERIAL		RAW DESCRIPTION		QTY UOM REV	
						01	
01 AS BUILT		4/22/2021 CDV		DRESS AND DEBURR ALL SHARP CORNERS AND EDGES		THREADS = CLASS 2 UNIFIED SERIES	
REV.		DATE		BY		DO NOT SCALE DRAWING	
						FORMAT D INV	